


Labor and Materials

.....	Copper } Connection.....	\$ 96
..... } Cock		
..... } T.S.&V.		
..... } Short 3 1/2 x 4 1/2		
..... } Long 4 1/2 x 5 1/2		
..... } Buff on Railway		
..... } Copper		
..... } Galv. Iron		
..... } Cast Iron		
..... } Pipe at 15	\$ 4.05	
.....	Nipples in. at	\$	
.....	Bushings to in. at	\$	
.....	Red'g } Couplings..... to in. at	\$	
.....	Inc'g }	\$	
.....	Union..... in. at	\$	
.....	Meter..... in. at	\$	
.....	Lbs. Br. Stone at	\$	
.....	Lbs. Sand at	\$	
.....	Bags Cement at	\$	
.....	Paving Brick { Mack		
..... } Red		
..... } Asphalt		
.....	Lead Joints at	\$	
.....	Leadite Joints at	\$	
.....	8 Hrs. Foreman at 6.2 1/2 hr	\$ 5.00	
.....	4 Hrs. Common Labor at 50	\$ 2.00	
.....	25 Hrs. Common Labor at	\$ 11.25	
.....	Hrs. Mason at	\$	
.....	Hrs. Masons Helper at	\$	
.....	4 Hrs. Compressor at 87 1/2 hr	\$ 3.50	
.....	Compensation Ins	\$.56	
.....	Trucking	\$ 1.-	
.....	Builders Use of Water	\$	
.....	<i>13 P</i> Total \$	\$ 31.00	

4776
Labor and Material Report

1 1936

32

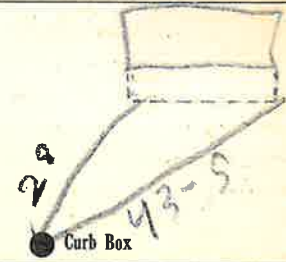

Main

Elev. of Main at tap 4

Gate at ●

● Gate at

● Curb Box

old top shut off

NOTE: From House
Left side - 34' - 3"
Right " - 48'