

LABOR AND MATERIALS

1. Copper Connection $\frac{3}{4}$	\$ 2.87
1. Lead	
1. Curb Valve T. S. & V. $\frac{3}{4}$ in.	\$ 3.62
1. Service box Short $3\frac{1}{2} \times 4\frac{1}{2}$	
Old returned Long $4\frac{1}{2} \times 5\frac{1}{2}$	4.68
29. Ft. $\frac{3}{4}$ in. G. I. Pipe at 37	\$ 7.68
Nipples in. at	\$
Bushings to in. at	\$
Red'g Inc'g Coupl'gs to in. at	\$
Union in. at	\$
Meter in. at	\$
2. Lead Joints at <i>Adaptor</i> $\frac{3}{8}$	\$ 7.0
Compound Joints at	\$
$3\frac{1}{2}$ Hrs. Water Maint. Man-1 at 1.12	\$ 3.92
10. Hrs. Water Maint. Man-2 at 1.02	\$ 10.20
42. Hrs. Labor at 91	\$ 38.22
Hrs. Labor at	\$
Hrs. Compressor at	\$
Compensation Ins. at \$ <i>2.18</i> per C	\$ 1.14
Trucking	\$ 2.00
Pav't Patch	\$ 10.25
<i>Tap by Mag. m. m. m.</i>	\$
	\$
O'head	\$
	\$ 85.28

101

St.
Pl.
Ave. No. 35-


Haskell

Name of Owner

Coffee

Labor and Mat'l. Report

Sept 20 19 49

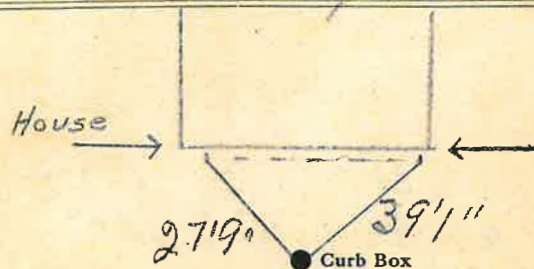

6 Main

Elev. of
Main at tap 5

Gate at ●

● Gate at

TAX ID # 303.18-9-7

Note: From Curb Box
Left Side 41'7" ?
Right " 32'3"