


Labor and Materials

1	Copper } Connection.....	$\frac{3}{4}$	\$	96
	Lead }			
	Curb { Cock Valve }	$\frac{3}{4}$	\$	1.33
1	Service Box { Short $3\frac{1}{2} \times 4\frac{1}{2}$ }		\$	1.35
	Old returned { Long $4\frac{1}{2} \times 6\frac{1}{2}$ }			
10	Ft. in. { Copper Galv. Iron } Pipe at	$\frac{1}{2}$	\$	1.50
	Nipples		\$	
	Bushings		\$	
	Red'g Inc'g } Couplings.....		\$	
	Union.....		\$	
	Meter.....		\$	
	Lbs. Br. Stone at		\$	
	Lbs. Sand at		\$	
	Bags Cement at		\$	
	Paving Brick { Mack Red Asphalt } at		\$	
	Lead Joints at		\$	
	Leadite Joints at		\$	
3	Hrs. Foreman at	6.25	\$	1.88
17	Hrs. Common Labor at	45	\$	7.65
	Hrs. Common Labor at		\$	
	Hrs. Mason at		\$	
	Hrs. Masons Helper at		\$	
	Hrs. Compressor at		\$	
	Compensation Ins		\$	1.29
	Trucking		\$	
	Builders Use of Waterpatch (CP)		\$	
Total \$				15.96

57¹⁰
 Labor and Material Report *401* 16, 19³⁶

39 Haskell Ave

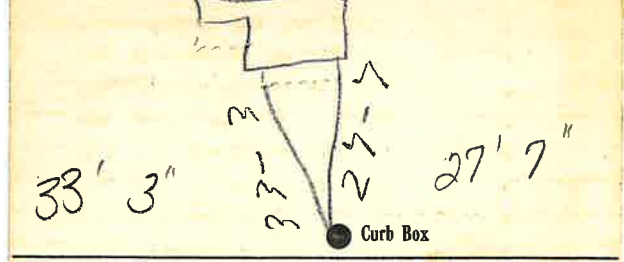

6 Main Elev. of Main at tap $4\frac{1}{2}$

Gate at ● Gate at ●

● Curb Box

*old lay slat of at
 frame*

W.D.