


LABOR AND MATERIALS

Copper	} Connection	_____	\$ _____
Lead			
Curb	} Cock Valve T. S. & V. }	_____ in.	\$ _____
Service box		} Short 3½ x 4½ Long 4½ x 5½ }	
Old returned			
15 Ft. ¾ in.	} Copper G.I. C.I. }	Pipe at	\$ _____
Nipples	in. at		\$ _____
Bushings	to _____ in. at		\$ _____
Red'g Inc'g	} Coupl'gs.	to _____ in. at	\$ _____
Union		in. at	\$ _____
Meter	in. at		\$ _____
			\$ _____
Compound Joints	at		\$ _____
Maintenance Foreman			\$ _____
Hrs. Water Maint. Man—1	at		\$ _____
Hrs. Water Maint. Man—2	at		\$ _____
Hrs. Garage Foreman	at		\$ _____
Hrs. Labor—	at		\$ _____
Hrs. Compressor	at		\$ _____
			\$ _____
Trucking			\$ _____
Pav't Patch			\$ _____
			\$ _____
			\$ _____
			\$ _____
			\$ _____

St. _____
Pt. _____
Ave. No. 41

Name of Owner _____

Labor and Mat'l. Report 19 90

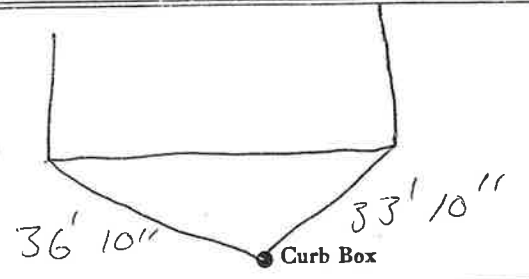

Main Elev. of
Main at tap
 Gate at ● ● Gate at

● Curb Box