


LABOR AND MATERIALS

1	Copper	} Connection	3/4"	\$	
1	Lead				
1	Curb	} Cock Valve T.S.&V.	3/4 in.	\$	
1	Service box		} Short 3 1/2 x 4 1/2 Long 4 1/2 x 5 1/2	4' x 5'	\$
	Old returned				
1/2	3/4 in.	} Copper C.I. C.I.			
	Nipples	in. at		\$	
	Bushings	to in. at		\$	
	Red'g	} Coupl'gs	to in. at	\$	
	Inc'g				
	Union	in. at		\$	
	Meter	in. at		\$	
	Lead Joints	at		\$	
	Compound Joints	at		\$	
	Maintenance Foreman			\$	
	Hrs. Water Maint. Man-1	at		\$	
	Hrs. Water Maint. Man-2	at		\$	
	Hrs. Garage Foreman	at		\$	
	Hrs. Labor	at		\$	
	Hrs. Compressor	at		\$	
	Compensation Ins. at \$	per C		\$	
	Trucking			\$	
	Pav't Patch			\$	
	TAP BY Beecher & Co			\$	
	Aug-14-1974			\$	
	O'head			\$	

Haskell Ave. No. 43


Name of Owner
John Deob

Labor and Mat'l. Report Aug 14 1974

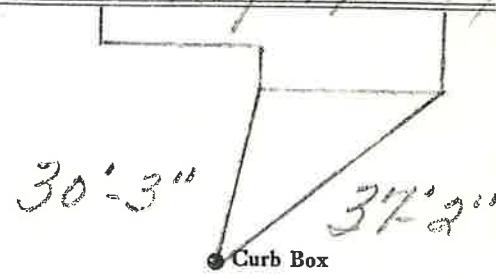

6" Main Elev. of Main at tap 4'

Gate at • Gate at •

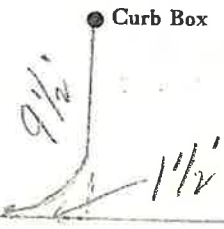

6" MAIN
LSM-5C-6-1-67
8' TO MAIN FROM CURB BOX