


Labor and Materials

1	Copper } Connection	3/4	\$ 2.20	
	Lead } Connection	3/4		
1	Curb } Cock	3/4 in.	\$ 1.00	
	Valve } T. S. & V.			
1	Service Box } Short 3 1/2 x 4 1/2		\$ 1.40	
	Old returned } Long 4 1/2 x 5 1/2			
		Buff. or Rdway		
1.0	Ft. 3/4 in.	Copper } Pipe at	\$ 2.20	
		Galv. Iron } Cast Iron		
	Nipples	in. at	\$	
	Bushings	to in. at	\$	
	Red'g } Couplings	to in. at	\$	
	Inc'g }			
	Union	in. at	\$	
	Meter	in. at	\$	
	Lbs. Br. Stone at		\$	
	Lbs. Sand at		\$	
	Bags Cement at		\$	
	Paving Brick } Mack	} at	\$	
				Red
				Asphalt
	Lead Joints at		\$	
	Leadite Joints at		\$	
2	Hrs. Foreman at		\$ 1.25	
2	Hrs. Common Labor at	50	\$ 1.00	
	Hrs. Common Labor at		\$	
	Hrs. Mason at		\$	
	Hrs. Mason's Helper at		\$	
	Hrs. Compressor at		\$	
	Compensation Ins.		\$ 1.06	
	Trucking		\$ 1.00	
	Builders' Use of Water		\$	
Total			\$ 11.11	

28-50

Labor and Material Report

1927

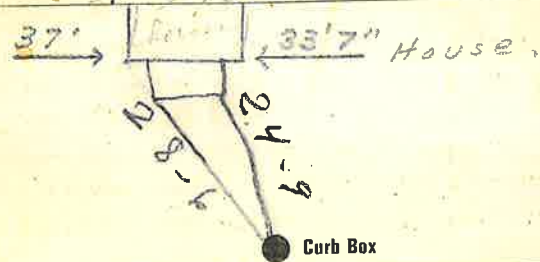

Main

Elev. of
Main at tap

5

Gate at ●

● Gate at

● Curb Box

Handwritten notes:
Main pipe
Curb Box