


Labor and Materials

1. Copper } Connection.....	\$ 1.50
1. Lead } Connection.....	\$ 1.50
1. Curb { Cock Valve T.S.&V. }in	\$ 1.70
1. Service Box { Short 3 1/2 x 4 1/2 Long 4 1/2 x 5 1/2 Buff. or Rdwan } Old returned	\$ 1.54
30 Ft. 3/4 in. { Copper Galv. Iron Cast Iron } Pipe at	\$ 5.70
.....Nipplesin. at	\$
.....Bushingstoin. at	\$
.....Red'g Inc'g } Couplings.....toin. at	\$
.....Union.....in. at	\$
.....Meter.....in. at	\$
.....Lbs. Br. Stone at	\$
.....Lbs. Sand at	\$
.....Bags Cement at	\$
.....Paving Brick { Mack Red Asphalt } at	\$
.....Lead Joints at	\$
.....Leadite Joints at	\$
3. Hrs. Foreman at 6 1/2 hr.	\$ 1.88
.....Hrs. Common Labor at	\$
.....Hrs. Common Labor at	\$
.....Hrs. Mason at	\$
.....Hrs. Masons Helper at	\$
.....Hrs. Compressor at	\$
.....Compensation Ins	\$ 0.07
.....Trucking	\$ 2.-
.....Builders Use of Water	\$
Total \$ 14.39	

70-34

Labor and Material Report Aug 16- 1934

47 Haskell Ave.

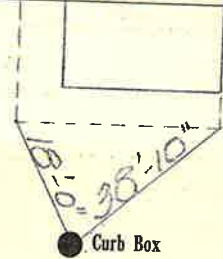

● Curb Box

6" Main

Elev. of Main at tap 5 1/2'

Gate at ●

● Gate at

● Curb Box