

Labor and Materials


1	Copper } Connection.....	3	\$ 1.25
1	Lead }	3	
1	Curb { Cock }	1	\$ 1.70
	{ Valve }		
	{ T.S.&V. }		
1	Service Box { Short 3 1/2 x 4 1/2 }	1	\$ 1.37
	Old returned { Long 4 1/2 x 5 1/2 }		
	{ Buff. or Rdway }		
28	3/4 in. { Copper } Pipe at 13 1/2		\$ 3.78
	{ Galv. Iron }		
	{ Cast Iron }		
.....	Nipples in. at		\$
.....	Bushings to in. at		\$
.....	Red'g } Couplings..... to in. at		\$
.....	Inc'g }		
.....	Union..... in. at		\$
.....	Meter..... in. at		\$
.....	Lbs. Br. Stone at		\$
.....	Lbs. Sand at		\$
.....	Bags Cement at		\$
.....	Paving Brick { Mack } at		\$
	{ Red }		
	{ Asphalt }		
.....	Lead Joints at		\$
.....	Leadite Joints at		\$
3	Hrs. Foreman at 62 1/2		\$ 1.88
A	Hrs. Common Labor at 50		\$ 2.-
28	Hrs. Common Labor at		\$ 12.60
.....	Hrs. Mason at		\$
.....	Hrs. Masons Helper at		\$
.....	Hrs. Compressor at		\$
.....	Compensation Ins. 62		\$
.....	Trucking 15		\$
.....	Builders Use of Water Patch 5-		\$
Total \$			31.20

1935-172

Labor and Material Report

19

48 Haskell Ave

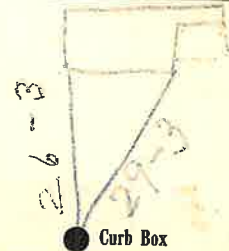

6 Main Elev of Main at tap 42

Gate at ● Gate at ●

● Curb Box

old level of at main
to be paid for.

MS