

Labor and Materials


1	Copper Lead	Connection	3/4"		\$
1	Curb	Cock Valve	3/4" Oriseal.	in	\$
1	Service Box	Short	3 1/2 x 4 1/2	} To 6'	\$
	Old returned	Long	4 1/2 x 5 1/2		
		Buff. or Rdway			
78	3/4" in.	Copper		Pipe at	\$
		Galv Iron			\$
		Cast Iron			\$
	Nipples	in. at			\$
	Bushings	to in. at			\$
	Red'g Inc'g	Conplings	to in. at		\$
	Union	in. at			\$
	Meter	in. at			\$
	Lead Joints	at			\$
	Leadite Joints	at			\$
	Hrs. Foreman	at			\$
	Hrs. Chauffeur	at			\$
	Hrs. Tapper	at			\$
	Hrs. Labor	at			\$
	Hrs. Labor	at			\$
	Hrs. Compressor	at			\$
	Compensation Ins.				\$
	Trucking				\$
	Builders Use of Water				\$
	Tap by GIFFORD + Co.				\$
	4-8-63.				\$

over 78

St. Haskell
Pt. Ave. No. 50

Name of Owner
Lee Clair

Labor and Mat'l. Report *April 8* 19*63*

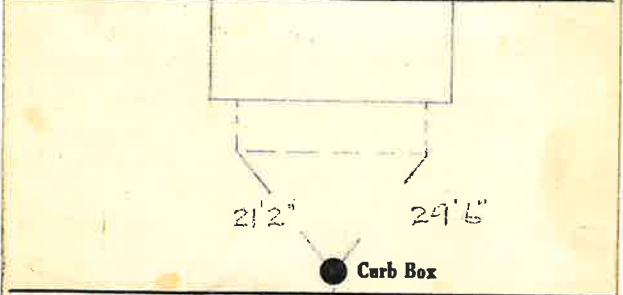

6" C.I. 30' Main Elev. of Main at tap *5 1/2*

Gate at ● ● Gate at

● Curb Box

Curb Stop