

Labor and Materials


..+..	Copper } Connection.....	$\frac{3}{4}$	\$ 1.33	
..+..	Lead }	$\frac{3}{4}$	\$ 1.58	
..+..	Curb { Cock Waste gasket }	in	\$ 1.36	
..+..	Service Box { Short $3\frac{1}{2} \times 4\frac{1}{2}$ Old returned { Long $4\frac{1}{2} \times 6\frac{1}{2}$ Ruth. or Railway }	\$ 95	
..+..	10 Ft. $\frac{3}{4}$ in. { Copper Galv. Iron Cast Iron }	Pipe at	\$	
.....	Nipples	in. at	\$	
.....	Bushings	to	in. at	\$	
.....	Red'g Inc'g }	Couplings.....	to	in. at	\$
.....	Union.....	in. at	\$	
.....	Meter.....	in. at	\$	
.....	Lbs. Br. Stone at	\$	
.....	Lbs. Sand at	\$	
.....	Bags Cement at	\$	
.....	Paving Brick { Mack Red Asphalt }	at	\$	
.....	Lead Joints at	\$	
.....	Leadite Joints at	\$	
3	Hrs. Foreman at	\$ 1.88	
2	Hrs. Common Labor at	\$ 4.00	
2	Hrs. Common Labor at	\$ 3.60	
.....	Hrs. Mason at	\$	
.....	Hrs. Masons Helper at	\$	
.....	Hrs. Compressor at	\$	
.....	Compensation Ins	\$ 29	
.....	Trucking	\$ 5	
.....	Builders Use of Water	Patch	\$ 5	
Total				\$ 20.99	

88-82

Labor and Material Report

Cont 31 33
19

51 Haskell Ave

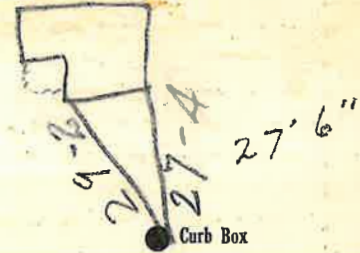

6 Main

Elev. of Main at tap 45

Gate at ●

● Gate at

● Curb Box

old connecting study

TAX ID # 303.18-2-1

C. K. Ellis