


LABOR AND MATERIALS

Copper } Connection _____ \$ _____
 Lead }
 Curb } Cock Valve } _____ in. _____ \$ _____
 T.S. & V. }
 Service box { Short 3-1/2 x 4-1/2 } _____ \$ _____
 Old returned { Long 4-1/2 x 5-1/2 }
 Ft. _____ in. { Copper } Pipe at _____ \$ _____
 { G.I. }
 { C.I. }
 Nipples _____ in. at _____ \$ _____
 Bushings _____ to _____ in. at _____ \$ _____
 Red'g _____
 Inc'g _____
 Union _____ in. at _____ \$ _____
 Meter _____ in. at _____ \$ _____
 _____ \$ _____
 Compound Joints at _____ \$ _____
 Maintenance Foreman _____ \$ _____
 Hrs. Water Maint. Man - 1 at _____ \$ _____
 Hrs. Water Maint. Man - 2 at _____ \$ _____
 Hrs. Garage Foreman _____ at _____ \$ _____
 Hrs. Labor _____ at _____ \$ _____
 Hrs. Compressor at _____ \$ _____
 _____ \$ _____
 Trucking _____ \$ _____
 Pav't Patch _____ \$ _____
 _____ \$ _____
 _____ \$ _____
HASKELL Ave. No. 52
 Name of Owner _____

Labor and Mat'l. Report ^{3/}~~2~~ 2012

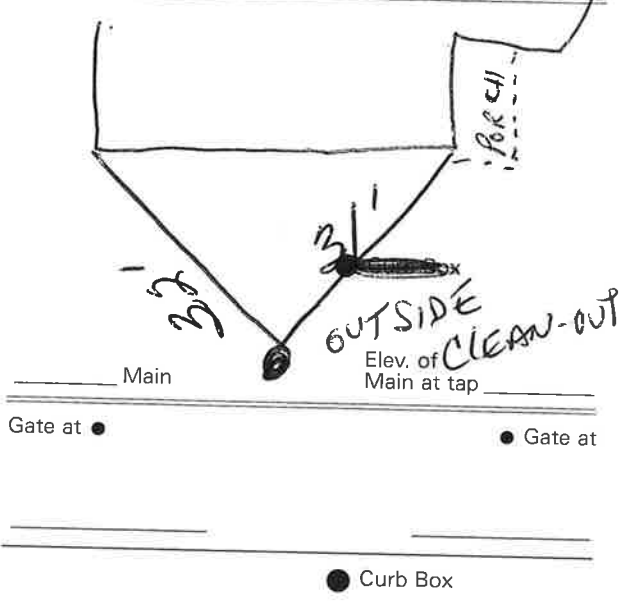

Labor and Materials

Copper } Connection.....	2	\$ 1.50
Lead }		
Curb { Cock Valve T.S.&V. }in	3	\$ 1.70
Service Box { Short 3 1/2 x 4 1/2 Long 4 1/2 x 5 1/2 Buff. or Rdway }		\$ 1.44
2.7 Ft. in. { Copper Galv. Iron Cast Iron } Pipe at	3 1/2	\$ 5.13
Nipples in. at		\$
Bushings to in. at		\$
Red'g Inc'g } Couplings..... to..... in. at		\$
Union..... in. at		\$
Meter..... in. at		\$
Lbs. Br. Stone at		\$
Lbs. Sand at		\$
Bags Cement at		\$
Paving Brick { Mack Red Asphalt } at		\$
Lead Joints at		\$
Leadite Joints at		\$
1 Hrs. Foreman at		\$ 0.63
4 Hrs. Common Labor at	50	\$ 2.00
4 Hrs. Common Labor at	45	\$ 1.80
Hrs. Mason at		\$
Hrs. Masons Helper at		\$
Hrs. Compressor at		\$
Compensation Ins		\$ 0.16
Trucking		\$ 1.00
Builders Use of Water		\$
Total \$		15.36

147 34

Labor and Material Report Nov 5 1911

52 Haskell Ave



Curb Box

6" Main

Elev. of Main at tap

Gate at

Gate at

Curb Box

Old trap about off
to be changed
see notes

[Handwritten signature]