


Labor and Materials

Lead Connection	\$
4 Curb Cock	\$
Service Box (Short 3 1/2 x 4 1/2)	\$
Old returned (Long 4 1/2 x 6 1/2)	\$
8 Ft. in. G. I. Pipe at <i>corner</i>	\$
Nipples in. at	\$
Bushings to..... in. at	\$
Red'g Coup to..... in. at	\$
Inc'g Coup to..... in. at	\$
Union in. at	\$
Meter in. at	\$
Cu. Yds. Br. Stone	at.....	\$
Cu. Yds. Sand	at.....	\$
Bags Cement	at.....	\$
Paving Brick { Mack Red Asphalt }	at.....	\$
2 Hrs. Foreman	at.....	\$
15 Hrs. Common Labor	at.....	\$
Hrs. Mason	at.....	\$
Hrs. at.....	\$
Hrs. at.....	\$
90 Builders' Use of Water at.....	\$
Truck 1.00 at.....	\$
..... at.....	\$
..... at.....	\$
Total	\$ 15.97	

Labor and Material Report

19 24

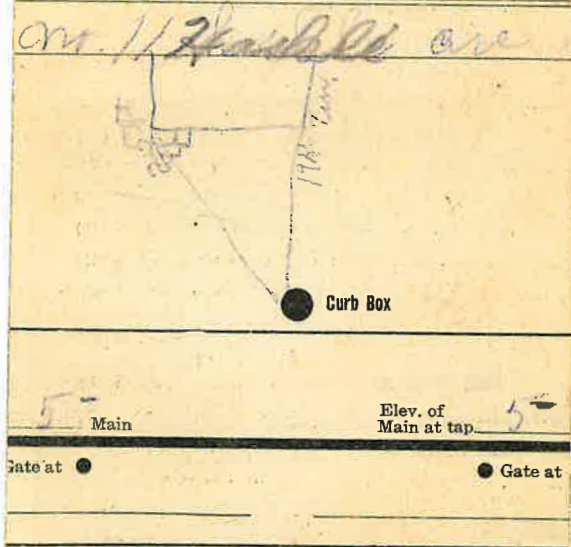

● Curb Box

and all curb ~~is~~
returned, shut off at
curb.

House Razed
After Fire 10-13-61

25' 19' 7"

House razed after fire 10-13-61