


Labor and Materials

| | | | |
|----|---|------------------|--------------|
| 1 | Copper } Connection | 94 | 3.20 |
| | Lead } | | |
| 1 | Curb } Cock Valve T.S. & V. } | 3/4 in. | 1.00 |
| 1 | Service Box } Short 3 1/2 x 4 1/2 } | | |
| | Old returned } Long 4 1/2 x 5 1/2 } | | 1.30 |
| | | Buil. or Rdway } | |
| 26 | Ft. 3/4 in. } Copper Galv. Iron Cast Iron } | | 5.72 |
| | Nipples..... in. at..... | | \$ |
| | Bushings..... to..... in. at..... | | \$ |
| 1 | Red'g } Couplings | 1/2 to 1 in. at | 1.5 |
| | Inc'g } | | |
| | Union..... in. at..... | | \$ |
| | Meter..... in. at..... | | \$ |
| | Lbs. Br. Stone at..... | | \$ |
| | Lbs. Sand at..... | | \$ |
| | Bags Cement at..... | | \$ |
| | Paving Brick } Mack Red Asphalt } | at | \$ |
| | Lead Joints at..... | | \$ |
| | Leadite Joints at..... | | \$ |
| 6 | Hrs. Foreman at..... | | 3.75 |
| | Hrs. Common Labor at..... | | \$ |
| 16 | Hrs. Common Labor at..... | | 6.50 |
| | Hrs. Mason at..... | | \$ |
| | Hrs. Mason's Helper at..... | | \$ |
| | Hrs. Compressor at..... | | \$ |
| | Compensation Ins..... | | 27 |
| 1 | Trucking..... | | 1.00 |
| | Builders' Use of Water..... | | \$ |
| | Total | | 27.89 |

27-125

Labor and Material Report 1927

3/4" tap at 62 Has Kall Ave

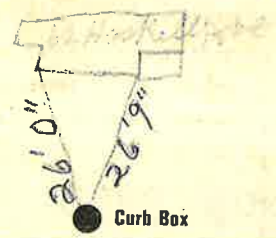

Curb Box

Main

Elev. of Main at tap

Gate at ●

● Gate at

● Curb Box

Old to be dug up