


LABOR AND MATERIALS

Copper	} Connection				\$				
Lead									
Curb	} Cock	} in.	}	}	\$				
	Valve								
	T. S. & V.								
Service box	} Short 3½ x 4½ } Long 4½ x 5½ }								
Old returned						\$			
Ft. 8 in.	} Copper } G. I. } C. I. }	} Pipe at	}	}	\$				
Nipples		in. at			\$				
Bushings		to		in. at	\$				
Red'g	} Coupl'gs	} to	}	}	\$				
Inc'g									
Union		in. at			\$				
Meter		in. at			\$				
					\$				
Compound Joints		at			\$				
Maintenance Foreman					\$				
Hrs. Water Maint. Man—1		at			\$				
Hrs. Water Maint. Man—2		at			\$				
Hrs. Garage Foreman		at			\$				
Hrs. Labor		at			\$				
Hrs. Compressor		at			\$				
					\$				
Trucking					\$				
Pav't Patch					\$				
					\$				
					\$				
					\$				
					\$				

St.
Pl.
Ave. No. 12

Name of Owner
VALCOOR

Labor and Mat'l. Report 1984

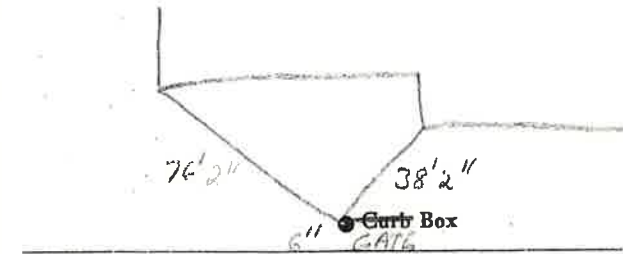

	Elev. of
Main	Main at tap
Gate at ●	● Gate at

● Curb Box

LSM-5C-6-1-67

76' 2" 6" gate box 38' 2"

1990

