

LABOR AND MATERIALS


1	Copper Lead	Connection	3/4"	\$ 3.08
1	Curb	Cock Valve T.S. & V.	3/4 in.	\$ 3.89
1	Service box	Short 3 1/2 x 4 1/2		
	Old returned	Long 4 1/2 x 5 1/2		\$ 4.32
25	Ft. 3/4 in.	Copper G.I. G.I.	Pipe at 45	\$ 11.25
	Nipples	in. at		\$
	Bushings	to in. at		\$
	Red'g Inc'g	Coupl'gs to in. at		\$
	Union	in. at		\$
	Meter	in. at		\$
	Lead Joints	at		\$
	Compound Joints	at		\$
4	Maintenance Foreman	1.937		\$ 7.75
	Hrs. Water Maint. Man	1 at		\$
15	Hrs. Water Maint. Man	2 at 1.613		\$ 24.20
4	Hrs. Garage Foreman	1.421		\$ 5.92
31	Hrs. Labor	at 1.30		\$ 40.30
	Hrs. Compressor	at		\$
	Compensation Ins.	at \$5.856 per C		\$ 1.44
	Trucking			\$ 1.50
	Pay't Patch			\$ 12.15
	Tap by Miller & Giggard			\$
	Miller & Kosmer	Oct 26		\$
	O'head Giggard & Co.			\$
	Oct. 30-31.			\$ 118.80

10665

St. _____
 Pl. _____
 Ave. No. 78

Name of Owner
 Robert O'Connor

Labor and Mat'l. Report Oct. 31 1956

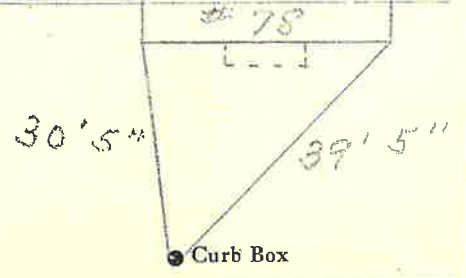

6" Main Elev. of Main at tap 6 1/2"
 Gate at • Gate at •

• Curb Box