

LABOR AND MATERIALS


Copper	} Connection	_____	\$ _____	
Lead				
Curb	} Cock Valve T.S. & V.	_____ in.	\$ _____	
Service box		} Short 3 1/2 x 4 1/2 } Long 4 1/2 x 5 1/2 }	_____	\$ _____
Old returned				
Ft. <u>3/4</u> in.	} Copper } C.I. }	Pipe at _____	\$ _____	
Nipples _____ in.		at _____	\$ _____	
Bushings _____ to _____ in.	at _____	\$ _____		
Red'g } Inc'g }	} Coupl'gs _____ to _____ in.	at _____	\$ _____	
Union _____ in.		at _____	\$ _____	
Meter _____ in.	at _____	\$ _____		
Compound Joints _____	at _____	\$ _____		
Maintenance Foreman _____		\$ _____		
Hrs. Water Maint. Man-1 _____	at _____	\$ _____		
Hrs. Water Maint. Man-2 _____	at _____	\$ _____		
Hrs. Garage Foreman _____	at _____	\$ _____		
Hrs. Labor _____	at _____	\$ _____		
Hrs. Compressor _____	at _____	\$ _____		
Trucking _____		\$ _____		
Pav't Patch _____		\$ _____		
_____		\$ _____		
_____		\$ _____		
_____		\$ _____		
_____		\$ _____		

HASKELL

St. 84
Pt. 84
Ave. No. 84

Name of Owner _____

Labor and Mat'l. Report 19 89

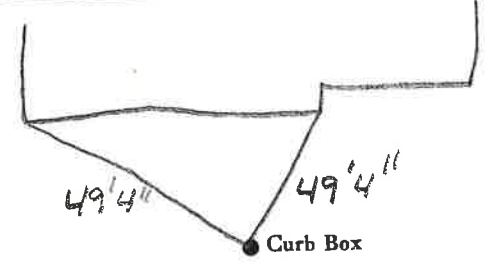

Main _____ Elev. of Main at tap _____
Gate at • _____ Gate at • _____

• Curb Box