


Labor and Materials

1	Copper } Connection	3	\$ 3.20
1	Lead } Connection	1	
1	Curb { Cock		
	{ Valve		
	{ T. S. & V. }	1	\$ 1.00
1	Service Box { Short 3 1/2 x 4 1/2		
	{ Long 4 x 5 1/2		
	{ Butt or Relay }		\$ 1.30
26	Ft. in. { Copper	3	\$ 5.22
	{ Cast Iron		
	{ Cast Iron } Pipe at		
	Nipples..... in. at.....		\$
	Bushings..... to..... in. at.....		\$
	Red'g } Couplings..... to..... in. at.....		\$
	{ Inc'g }		
	Union..... in. at.....		\$
	Meter..... in. at.....		\$
	Lbs. Br. Stone at.....		\$
	Lbs. Sand at.....		\$
	Bags Cement at.....		\$
	Paving Brick { Mack		
	{ Red		
	{ Asphalt }		\$
	Lead Joints at.....		\$
	Leadite Joints at.....		\$
5	Hrs. Foreman at.....	2.13	\$ 2.13
18	Hrs. Common Labor at.....	7.31	\$ 7.31
	Hrs. Common Labor at.....		\$
	Hrs. Mason at.....		\$
	Hrs. Mason's Helper at.....		\$
	Hrs. Compressor at.....		\$
	Compensation Ins.....	28	\$ 28
	Trucking.....	1.00	\$ 1.00
	Builders' Use of Water.....		\$
Total			\$ 229.4

OLGA DE JULIO

Labor and Material Report Sept 15 1925

70 HOSKELL DR
86

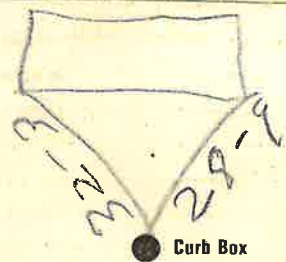

6 Main Elev. of Main at tap 11 1/2

Gate at ● Gate at ●

● Curb Box