


LABOR AND MATERIALS

1 Copper } Connection 1 1/2 " \$ _____
 Lead }
 1 Curb } Cock } 2 in. - Stop & Write
 Valve }
 T.S. & V. }
 1 Service box } Short 3 1/2 x 4 1/2 }
 Old returned } Long 4 1/2 x 5 1/2 } \$ _____
 Buff or Rdway }
 6 Ft. 2 " in. } Copper } Pipe at \$ _____
 } G.I. }
 } C.I. }
 Nipples _____ in. at \$ _____
 1 Bushings Cop to I.P. in. at \$ _____
 Red'g }
 Inc'g } Coupl'gs _____ to _____ in. at \$ _____
 Union _____ in. at 11' Copper 2" to
 Meter _____ in. at Manhole \$ _____
 Lead Joints at \$ _____
 Compound Joints at \$ _____
 Maintenance Foreman \$ _____
 Hrs. Water Maint. Man-1 at \$ _____
 Hrs. Water Maint. Man-2 at \$ _____
 Hrs. Garage Foreman _____ at \$ _____
 Hrs. Labor- _____ at \$ _____
 Hrs. Compressor at \$ _____
 Compensation Ins. at \$ _____ per C \$ _____
 Trucking \$ _____
 Pav't Patch \$ _____
 _____ \$ _____
Tap April 14, 1980 \$ _____
Bechtel Co. \$ _____
 O'head \$ _____
 \$ _____

Haskell St. _____
 Pl. _____
 Ave. No. 87

Name of Owner
City of Glens Falls

Labor and Mat'l. Report April 14 1980

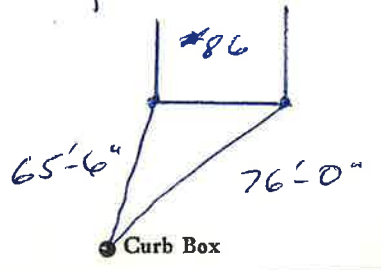

6" Main Elev. of Main at tap 7'
 Gate at ● Gate at ●

● Curb Box