


LABOR AND MATERIALS

Copper } Connection _____	\$ _____
Lead } _____	\$ _____
Curb } Cock } _____ in.	\$ _____
	Valve } _____
	T. S. & V. } _____
Service box { Short 3½ x 4½ }	
Old returned { Long 4½ x 5½ }	\$ _____
6 Ft. ¾ in. { Copper } Pipe at _____	\$ _____
	{ G.I. }
	{ C.I. }
Nipples _____ in. at _____	\$ _____
Bushings _____ to _____ in. at _____	\$ _____
Red'g } Coupl'gs _____ to _____ in. at _____	\$ _____
Inc'g } _____	\$ _____
Union _____ in. at _____	\$ _____
Meter _____ in. at _____	\$ _____
_____	\$ _____
Compound Joints at _____	\$ _____
Maintenance Foreman _____	\$ _____
Hrs. Water Maint. Man—1 at _____	\$ _____
Hrs. Water Maint. Man—2 at _____	\$ _____
Hrs. Garage Foreman _____ at _____	\$ _____
Hrs. Labor— _____ at _____	\$ _____
Hrs. Compressor at _____	\$ _____
_____	\$ _____
Trucking _____	\$ _____
Pav't Patch _____	\$ _____
_____	\$ _____
_____	\$ _____
Haskell St.
Pl.
Ave. No. 90-96

Name of Owner _____

Labor and Mat'l. Report 19

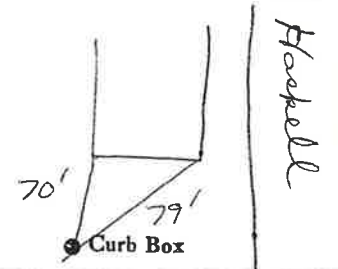

Dix Ave
12 Main Elev. of
Main at tap _____

Gate at • • Gate at

TAX ID #303.14-4-2

• Curb Box

Tap on Dix Ave.