

LABOR AND MATERIALS

Copper	} Connection _____	\$ _____	
Lead			
Curb	} Cock _____	in. _____ \$ _____	
			} Valve _____
Service box	} Short $3\frac{1}{2} \times 4\frac{1}{2}$ _____	\$ _____	
			Old returned } Long $4\frac{1}{2} \times 5\frac{1}{2}$ _____
Ft. $\frac{3}{4}$ in.	} C.I. Pipe at _____	\$ _____	
			C.I.
Nipples	in. at _____	\$ _____	
Bushings	to _____ in. at _____	\$ _____	
Red'g } Coupl'gs _____	to _____ in. at _____	\$ _____	
Inc'g }			
Union	in. at _____	\$ _____	
Meter	in. at _____	\$ _____	
Compound Joints	at _____	\$ _____	
Maintenance Foreman	_____	\$ _____	
Hrs. Water Maint. Man—1	at _____	\$ _____	
Hrs. Water Maint. Man—2	at _____	\$ _____	
Hrs. Garage Foreman	at _____	\$ _____	
Hrs. Labor—	at _____	\$ _____	
Hrs. Compressor	at _____	\$ _____	
Trucking	_____	\$ _____	
Pav't Patch	_____	\$ _____	
_____	_____	\$ _____	
_____	_____	\$ _____	
_____	_____	\$ _____	
_____	_____	\$ _____	


HASKELL

St. _____
 Pt. _____
 Ave. No. 13

Name of Owner _____

Labor and Mat'l. Report _____

19 89

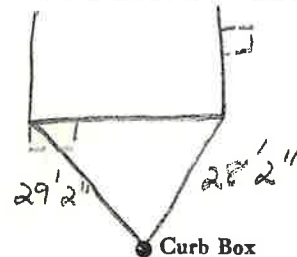

● Curb Box

_____ Main

Elev. of

Main at tap _____

Gate at ● _____

● Gate at _____

● Curb Box

Labor and Materials

Copper } Connection.....	3	\$ 2.60
Lead }		
Curb } Cock }		\$ 2.30
} Valve }		
} T.S. & V. }		
Service Box } Short 3 1/2 x 4 1/2 }		\$ 1.40
Old returned } Long 4 1/2 x 5 1/2 }		
} Buff. or Rdway }		
Ft. in. } Copper } Pipe at.....	3	\$ 2.12
} Galv. Iron }		
} Cast Iron }		
Nipples..... in. at.....		\$
Bushings..... to..... in. at.....		\$
Red'g } Couplings..... to..... in. at.....		\$
Inc'g }		
Union..... in. at.....		\$
Meter..... in. at.....		\$
Lbs. Br. Stone at.....		\$
Lbs. Sand at.....		\$
Bags Cement at.....		\$
Paving Brick } Mack } at.....		\$
} Red }		
} Asphalt }		
Lead Joints at.....		\$
Leadite Joints at.....		\$
3 Hrs. Foreman at.....		\$ 1.88
16 Hrs. Common Labor at.....		\$ 6.50
Hrs. Common Labor at.....		\$
Hrs. Mason at.....		\$
Hrs. Mason's Helper at.....		\$
Hrs. Compressor at.....		\$
Compensation Ins.....		\$ 22
Trucking.....		\$ 1.00
Builders' Use of Water Patch.....		\$ 5.10


Total \$ 23.02

29-140

Labor and Material Report

19

13 Haskell Ave

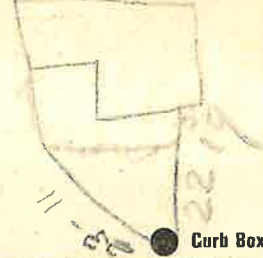

Main Elev of Main at tap

Gate at ● ● Gate at

● Curb Box

Old tap shut off
 House Razed
 After Fire 10-13-61
 shut off at curb.