

LABOR AND MATERIALS

Copper	Lead	Connection	-----	\$	
Curb	Cock' Valve	T. S. & V.	-----	in.	\$
			-----	in.	\$
Service Box	Old returned	Short 3 1/2 x 4 1/2 Long 4 1/2 x 5 1/2 Buff. or Rdway	-----		\$
			Copper Galv. Iron Cast Iron	-----	Pipe at
				17 Ft. 3/4 in.	
Nipples		in. at	-----		\$
Bushings		to in. at	-----		\$
Red'g Inc'g	Couplings	to in. at	-----		\$
Union		in. at	-----		\$
Meter		in. at	-----		\$
Lead Joints		at	-----		\$
Leadite Joints		at	-----		\$
Hrs. Foreman		at	-----		\$
Hrs. Chauffeur		at	-----		\$
Hrs. Tapper		at	-----		\$
Hrs. Labor		at	-----		\$
Hrs. Labor		at	-----		\$
Hrs. Compressor		at	-----		\$
Compensation Ins.			-----		\$
Trucking			-----		\$
Builders Use of Water			-----		\$
			-----		\$
			-----		\$
			-----		\$
			-----		\$

St.
Pt.
Ave. No. 16-18


Haskell

Name of Owner

Guglielmo

Labor and Mat'l. Report July 18

1936

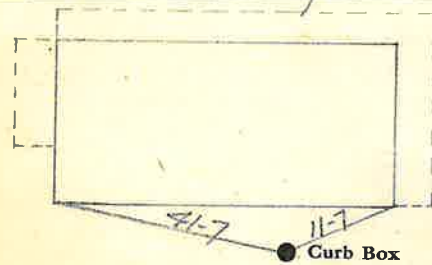

6" Main Lane Elev. of Main at tap 4 1/2'

Gate at ● Gate at ●

● Curb Box

Old tap dug up
and shut off.