


### Labor and Materials

1	Copper } Connection	3	\$ 320
	Lead } S.S. & V.	4	
1	Curb } Cock Valve	2	\$ 1.00
	} S.S. & V.	4	
1	Service Box } Short 3 1/2 x 4 1/2		\$ 1.30
	Old returned } Long 4 1/2 x 5 1/2		
	} Bull or Rdway		
2 1/4	Ft. } in. } Copper		\$ 528
	} in. } Connection		
	Nipples	in. at	\$
	Bushings	to in. at	\$
	Red'g } Couplings	to in. at	\$
	Inc'g }		
	Union	in. at	\$
	Meter	in. at	\$
	Lbs. Br. Stone	at	\$
	Lbs. Sand	at	\$
	Bags Cement	at	\$
	Paving Brick } Mack	} at	\$
	} Red		
	} Asphalt		
	Lead Joints	at	\$
	Leadite Joints	at	\$
3	Hrs. Foreman	at	\$ 187
14	Hrs. Common Labor	at	\$ 578
	Hrs. Common Labor	at	\$
	Hrs. Mason	at	\$
	Hrs. Mason's Helper	at	\$
	Hrs. Compressor	at	\$
1	Compensation Ins.		\$ 20
1	Trucking		\$ 1.50
	Builders' Use of Water		\$
Total			\$ 1963

### Labor and Material Report

14 19 27

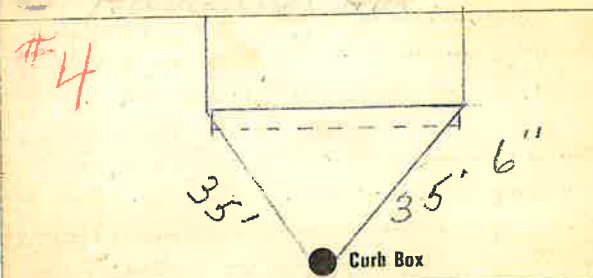

Main Elev. of Main at tap 4 1/2

Gate at ● ● Gate at

● Curb Box

A. Desjardins