


**Labor and Materials**

1	Copper	Connection	3/4	\$	3.20
	Lead				
1	Curb	Cock Valve T. S. & V.	3/4 in.	\$	1.00
1	Service Box	Short 34 x 44		\$	1.40
	Old returned	Long 44 x 54			
		Buff. or Rdway			
25	Ft.	3/4 in. Copper Galv. Iron Cast iron	Pipe at	\$	5.00
	Nipples	in. at		\$	
	Bushings	to in. at		\$	
1	Red g In. g	Couplings	2 1/4 to in. at	\$	1.50
	Union	in. at		\$	
	Meter	in. at		\$	
	Lbs. Br. Stone	at		\$	
	Lbs. Sand	at		\$	
	Bags Cement	at		\$	
	Paving Brick	Mack Red Asphalt at		\$	
	Lead Joints	at		\$	
	Leadite Joints	at		\$	
1	Hrs. Foreman	at		\$	.63
6	Hrs. Common Labor	at	1.00	\$	3.00
11	Hrs. Common Labor	at	4.06	\$	4.46
	Hrs. Mason	at		\$	
	Hrs. Mason's Helper	at		\$	
	Hrs. Compressor	at		\$	
	Compensation Ins.			\$	1.21
1	Trucking			\$	1.00
	Builders' Use of Water			\$	
				Total	\$ 20.55

**Labor and Material Report**

19 13

20 ?  
18  
not Harvard Ave.

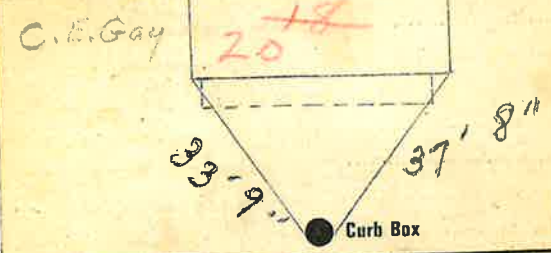

Main Eley. of Main at tap 5-1  
Gate at ● Gate at ●

● Curb Box

new house