


LABOR AND MATERIALS

1 Copper lead } Connection $\frac{3}{4}$ " \$
 1 Curb } Cock Valve } $\frac{3}{4}$ " in. (MARKED ORISER)
 1 Service box } Short $3\frac{1}{2}$ x $4\frac{1}{2}$ " }
 Old returned } Long $4\frac{1}{2}$ x $5\frac{1}{2}$ " }
 29 $\frac{3}{4}$ Ft. } Copper } Pipe at \$
 Nipples in. at \$
 Bushings to in. at \$
 Red'g } Coupl'gs to in. at \$
 Inc'g }
 Union in. at \$
 Meter in. at \$
 Lead Joints at \$
 Compound Joints at \$
 Maintenance Foreman \$
 Hrs. Water Maint. Man-1 at \$
 Hrs. Water Maint. Man-2 at \$
 Hrs. Garage Foreman at \$
 Hrs. Labor at \$
 Hrs. Compressor at \$
 Compensation Ins. at \$ per C \$
 Trucking \$
 Pav't Patch \$
 Tap Made By Beecher \$
 JUNE 4-1974 \$
 O'head \$

HAVILAND Ave. No. 22

Name of Owner Willie HAMMER

Labor and Mat'l. Report JUNE 4 1974

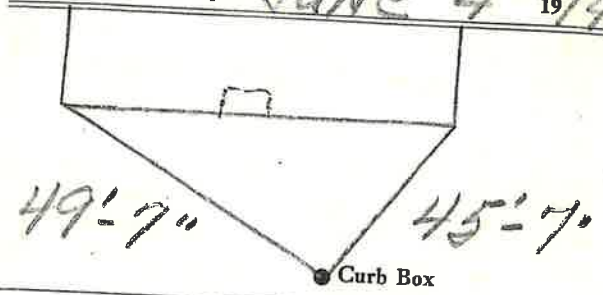

4" Main Elev. of Main at tap 5'
 Gate at • Gate at •

• Curb Box