


**Labor and Materials**

1	Copper	} Connection	3/4	\$ 3.20
	Lead			
1	Curb	} Cock Valve T.S. & V.	3/4 in.	\$ 1.00
1	Service Box	} Short 3 1/2 x 4 1/2		\$ 1.30
	Old returned			
			Buff. or Rdway	
7	Ft. 3/4 in.	} Copper Galv. Iron Cast Iron	Pipe at.	\$ 1.54
	Nipples	in. at		\$
	Bushings	to in. at		\$
	Red'g Inc'g	} Couplings	to in. at	\$
	Union	in. at		\$
	Meter	in. at		\$
	Lbs. Br. Stone	at		\$
	Lbs. Sand	at		\$
	Bags Cement	at		\$
	Paving Brick	} Mack Red Asphalt	at	\$
	Lead Joints	at		\$
	Leadite Joints	at		\$
3	Hrs. Foreman	at		\$ 1.87
2	Hrs. Common Labor	at		\$ .81
	Hrs. Common Labor	at		\$
	Hrs. Mason	at		\$
	Hrs. Mason's Helper	at		\$
	Hrs. Compressor	at		\$
	Compensation Ins.			\$ 1.07
	Trucking			\$ 1.00
	Builders' Use of Water			\$
	<b>Total</b>			<b>\$ 10.79</b>

27-139

*3/4 Tap at 23 Hilliard Ave*

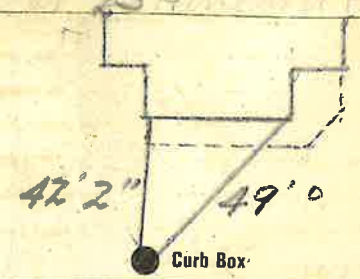

*1 1/2\"/>*

Gate at ● ● Gate at

● Curb Box

*Old tap to be dug up  
Old Tap dug up AND  
Disconnected at  
Main 5-23-55*