


Labor and Materials

1	Lead Connection ^{1/2"}	\$
1	Curb Cock ^{3/4"}	\$
1	Service Box { Short 8 1/2 x 4 1/2 Old returned { Long 4 1/2 x 5 1/2 Buffalo	\$
8	Ft. ^{3/4} in. ⁶ + Pine at	\$
	Nipples..... in. at	\$
	Bushings..... in. at	\$
	Red'g Coup... to... in. at	\$
	Inc'g Coup... to... in. at	\$
	Union... in. at	\$
	Meter... in. at	\$
	Cu. Yds. Br. Stone at	\$
	Cu. Yds. Sand at	\$
	Bags Cement at	\$
	Pay. Brick { Mack Red Asphalt } at	\$
2 1/2	Hrs. Foreman at	\$
5	Hrs. Com. Labor at	\$
	Hrs. Mason at	\$
	Hrs. at	\$
	Hrs. at	\$
9.00	Builders' Use of Water	\$
	TRUCK 100	\$
		\$
		\$
		\$
		\$
	Total	\$ 9.50

Labor and Material Report *May 28* 1923

1/2" tap at 25 Haselwood Ave

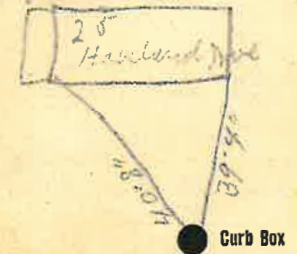

TAX ID # 309.15-4-7

4 Main Elev. of Main at tap *5.76*

Gate at ● Gate at ●

● Curb Box

RENEWAL TAP - 1997

Drawn in Books July 11, 1923 J.C.P.