

LABOR AND MATERIALS

| | | | | | |
|---|-------------------------|-----------------------|--------------------|----|-------|
| 1 | Copper Lead | Connection | 3/4" | \$ | 2.41 |
| 1 | Curb | Cock Valve T. S. & V. | 3/4 in. | \$ | 3.41 |
| 1 | Service box | Short 3 1/2 x 4 1/2 | | \$ | 4.15 |
| | Old returned | Long 4 1/2 x 5 1/2 | | \$ | |
| | | Buff or Rdway | | \$ | |
| 9 | Ft. | Copper G. I. C. I. | 3/4 in. Pipe at 40 | \$ | 3.60 |
| | Nipples | in. at | | \$ | |
| | Bushings | to in. at | | \$ | |
| | Red'g Inc'g | Coupl'gs to in. at | | \$ | |
| | Union | in. at | | \$ | |
| | Meter | in. at | | \$ | |
| | Lead Joints | at | | \$ | |
| | Compound Joints | at | | \$ | |
| | Maintenance Foreman | | | \$ | |
| | Hrs. Water Maint. Man-1 | at | | \$ | |
| 7 | Hrs. Water Maint. Man-2 | at 1.24 | | \$ | 8.68 |
| | Hrs. Garage Foreman | at | | \$ | |
| 5 | Hrs. Labor | at 1.13 | | \$ | 9.04 |
| | Hrs. Compressor at | | | \$ | |
| | Compensation Ins. at | 3.961 per C | | \$ | 68 |
| | Trucking | | | \$ | 1.50 |
| | Pay't Patch | | | \$ | 9.00 |
| | O'head | | | \$ | |
| | | | | \$ | 42.50 |

33.50


Tap by Gifford 8-26-54

56-54

St. Haviland Pl. Ave. No. 27

Name of Owner Fitzgerald

Labor and Mat'l. Report Aug. 26 1954

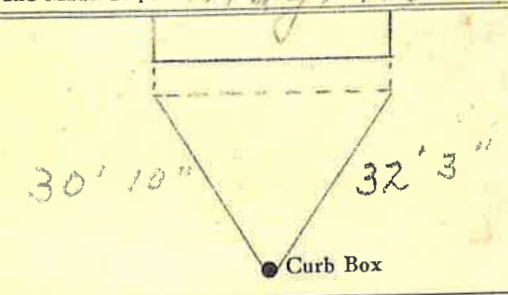

4" Main Elev. of Main at tap 5 1/2'

Gate at • Gate at •

TAX ID # 309.15-4-8

• Curb Box