

### Labor and Materials

1	Copper	} Connection	.....	\$	
	Lead				
1	Curb	{ Cock Valve T.S. & V. }	{ 3/4" in. }	\$	
	Service Box	{ Short 3 1/2 x 4 1/2 }		\$	
	Old returned	{ Long 4 1/2 x 5 1/2 }		\$	
		{ Buff. or Rdway }		\$	
23	Ft. 3/4	{ Copper Galv. Iron Cast Iron }	{ Pipe at. }	\$	
	Nipples	in. at		\$	
	Bushings	to in. at		\$	
1	Red'g Inc'g	{ Couplings }	{ to in. at. }	\$	
	Union	in. at		\$	
	Meter	in. at		\$	
	Lbs Br. Stone	at		\$	
	Lbs. Sand	at		\$	
	Bags Cement	at		\$	
	Paving Brick	{ Mack Red Asphalt }	{ at }	\$	
	Lead Joints	at		\$	
	Leadite Joints	at		\$	
	Hrs. Foreman	at		\$	
13	Hrs. Common Labor	at		\$	
	Hrs. Common Labor	at		\$	
	Hrs. Mason	at		\$	
	Hrs. Mason's Helper	at		\$	
	Hrs. Compressor	at		\$	
	Compensation Ins.			\$	
	Trucking			\$	
1/4	Builders' Use of Water			\$	
Total \$					1348

### Labor and Material Report

June 19

19

3/4 tap at 74 Highland Ave

(New tap)

See Below





14" Main

Elev. of Main at tap 4 1/2'

Gate at ●


● Gate at

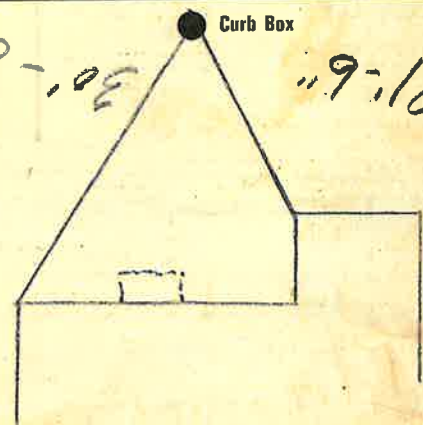

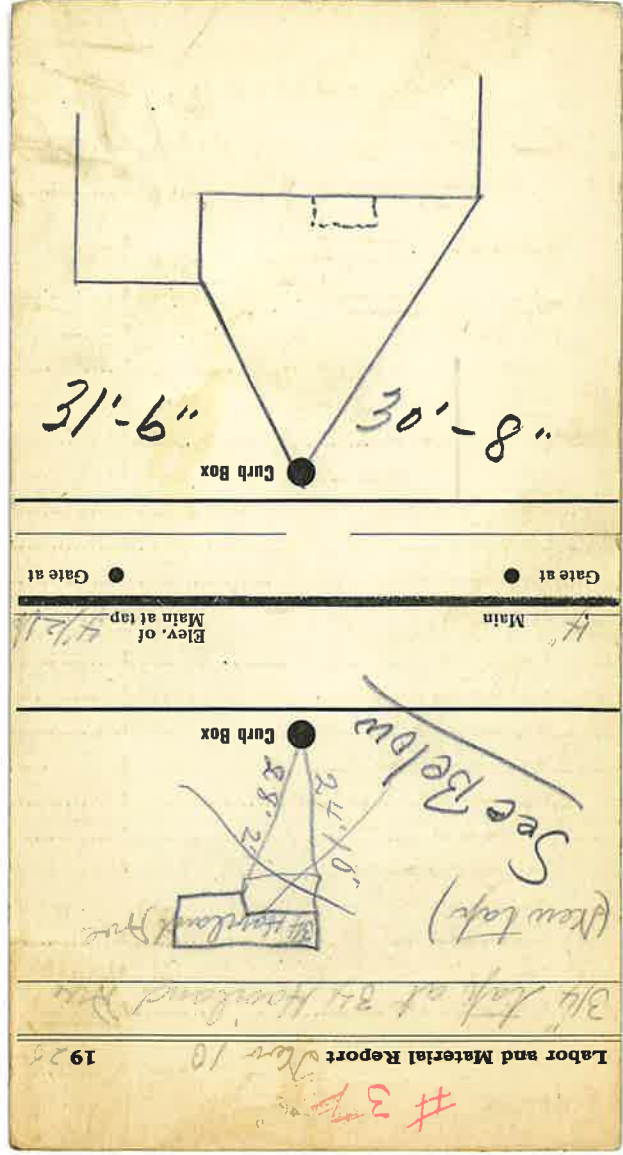

Gate at ● Gate at ●

Main Elev. of Main at tap 47.1

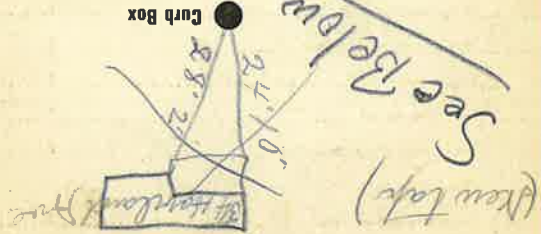

314 Tap at 314 Horizontal Pipe  
 Labor and Material Report Nov 10 1928

# 37