


Labor and Materials

Copper	{	Connection	\$
Lead			\$
Curb	{	Cock Valve T. S. & V. } in	\$
.....			\$
Service Box	{	Short 3 1/2 x 4 1/2 Long 4 1/2 x 5 1/2 Buff. or Rdway	\$
Old returned			\$
.....			\$
Ft. in.	{	Copper Galv Iron Cast Iron	Pipe at	\$
.....			\$
Nipples in. at	\$	
Bushings to in. at	\$	
Red'g Inc'g	{	Conplings to	\$
.....		 in. at	\$
Union in. at	\$	
Moter in. at	\$	
Lead Joints	at	\$	
Leadite Joints	at	\$	
Hrs. Foreman	at	\$	
Hrs. Chauffeur	at	\$	
Hrs. Tapper	at	\$	
Hrs. Labor	at	\$	
Hrs. Labor	at	\$	
Hrs. Compressor	at	\$	
Compensation Ins.	\$	
Trucking	\$	
Builders Use of Water	\$	
.....	\$	
.....	\$	
St. 34
 -Pi.
 Ave. No. 32

Name of Owner

Labor and Mat'l. Report April 11-38 19

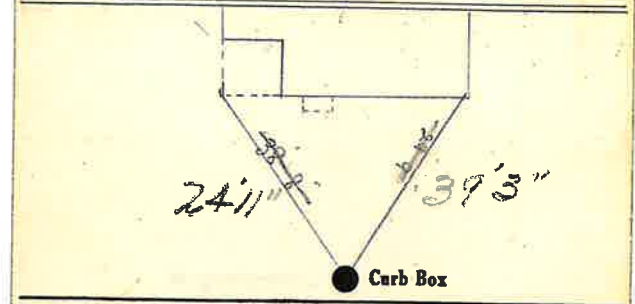

.....Main Elev. of
Main at tap

Gate at • • Gate at

● Curb Box