

LABOR AND MATERIALS

1	Copper	{	Connection $3/4"$			\$ 2.76
	Lead					
1	Curb	{	Cock	$3/4$ in.	\$ 3.49	
			Valve			
			T. S. & V.			
1	Service box	{	Short $3/4" \times 4 1/2"$	}	\$ 4.74	
	Old returned		Long $4 1/2" \times 5 1/2"$			
			Buff or Rdway			
2.8	$3/4$ in.	{	Copper	}	\$ 10.64	
	Ft.		Pipe at 58			
			C.I.			
			C.I.			
	Nipples	in.	at		\$	
	Bushings	to	in.	at	\$	
	Inc'g	Coupl'gs	to	in.	at	\$
	Union	in.	at		\$	
	Meter	in.	at		\$	
	Lead Joints	at			\$	
	Compound Joints	at			\$	
	Hrs. Water Maint. Man-1	at			\$	
6	Hrs. Water Maint. Man-2	at	1.24		\$	7.44
2.2	Hrs. Labor-	at	1.13		\$	24.86
	Hrs. Labor-	at			\$	
	Hrs. Compressor	at			\$	
	Compensation Ins.	at	4.406 per C.		\$	1.42
	Trucking				\$	1.00
	Pav't Patch				\$	17.10
Tap by G.I.S. on rd 6-18-53						
	O'head				\$	

\$ 73.45

5635


14-53

364
Pl. ~~36~~
Ave. No. 36

Haviland

Name of Owner
Crippen

Labor and Mat'l. Report June 18 1952

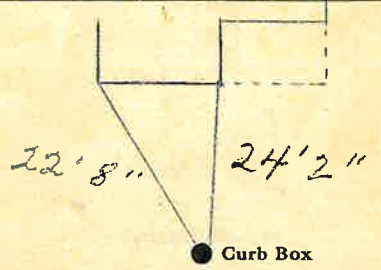

4" Main Elev. of Main at tap 4' 1/2"
Gate at ● ● Gate at

● Curb Box