


LABOR AND MATERIALS

1 Copper } Connection 3/4" \$ _____
 1 Lead }
 1 Curb } Cock } 3/4" Oriseal \$ _____
 } Valve }
 } T.S. & V. }
 1 Service box { Short 3 1/2 x 4 1/2 }
 Old returned { Long 4 1/2 x 5 1/2 }
 } Buff. or Rdway } \$ _____
 10 Ft. 3/4 in. { Copper } Pipe at \$ _____
 } G.I. }
 } C.I. }
 Nipples..... in. at \$ _____
 Bushings to in. at \$ _____
 Red'g }
 Inc'g } Coupl'gs to in. at \$ _____
 Union in. at \$ _____
 Meter in. at \$ _____
 Lead Joints at \$ _____
 Compound Joints at \$ _____
 Maintenance Foreman \$ _____
 Hrs. Water Maint. Man—1 at \$ _____
 Hrs. Water Maint. Man—2 at \$ _____
 Hrs. Garage Foreman at \$ _____
 Hrs. Labor— at \$ _____
 Hrs. Compressor at \$ _____
 Compensation Ins. at \$ _____ per C \$ _____
 Trucking \$ _____
 Pav't Patch \$ _____
Tap by Gifford & Co. \$ _____
8-6-64 \$ _____
 O'head \$ _____
 \$ _____

St. _____
 Pl. _____
 Ave. No. 39

Name of Owner
Edwin Wento

Labor and Mat'l. Report 19

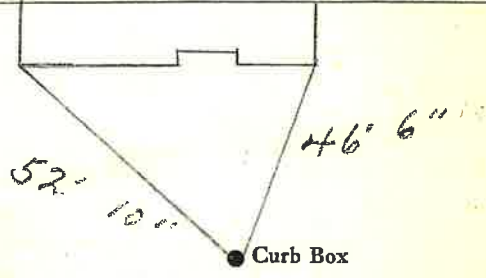

4" Main Elev. of Main at tap 4'
 Gate at ● ● Gate at

● Curb Box