

LABOR AND MATERIALS

Copper	} Connection		\$	
Lead				
Curb	} Cock Valve } T. S. & V. }	in.	\$	
Service box		} Short 3 1/2 x 4 1/2 } Long 4 1/2 x 5 1/2 }		
Old returned				\$
Ft. 3/4 in.	} Copper } <del>C.I.</del> }	Pipe at	\$	
Nipples	in. at		\$	
Bushings	to in. at		\$	
Red'g } Inc'g }	Coupl'gs to in. at		\$	
Union	in. at		\$	
Meter	in. at		\$	
			\$	
Compound Joints	at		\$	
Maintenance Foreman			\$	
Hrs. Water Maint. Man-1	at		\$	
Hrs. Water Maint. Man-2	at		\$	
Hrs. Garage Foreman	at		\$	
Hrs. Labor	at		\$	
Hrs. Compressor	at		\$	
			\$	
Trucking			\$	
Pav't Patch			\$	
			\$	
			\$	
			\$	
			\$	

HAYILAND


St. Pl. Ave. No. 41

Name of Owner

GUY

Labor and Mat'l. Report

1973

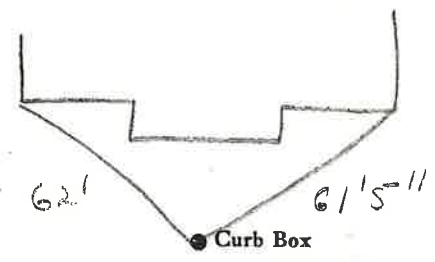

Main Elev. of Main at tap  
Gate at • Gate at •

• Curb Box