


## LABOR AND MATERIALS

Copper	Lead	Connection		\$	
Curb	}	Cock	} in.	\$	
		Valve			
		T. S. & V.			
Service box	}	Short $3\frac{1}{2} \times 4\frac{1}{2}$	}	\$	
		Long $4\frac{1}{2} \times 5\frac{1}{2}$			
Old returned				\$	
Ft.	$3/4$ in.	} Copper	} Pipe at	\$	
Nipples	in.	at		\$	
Bushings	to	in.	at	\$	
Red'g	} Coupl'gs	to	in.	at	\$
Inc'g					
Union	in.	at		\$	
Meter	in.	at		\$	
				\$	
Compound Joints	at			\$	
Maintenance Foreman				\$	
Hrs. Water Maint. Man	—1	at		\$	
Hrs. Water Maint. Man	—2	at		\$	
Hrs. Garage Foreman		at		\$	
Hrs. Labor		at		\$	
Hrs. Compressor	at			\$	
				\$	
Trucking				\$	
Pav't Patch				\$	
				\$	
				\$	
				\$	
				\$	

St. HAYLAND  
 Pt. Ave. No. 42

Name of Owner \_\_\_\_\_

Labor and Mat'l. Report 1972

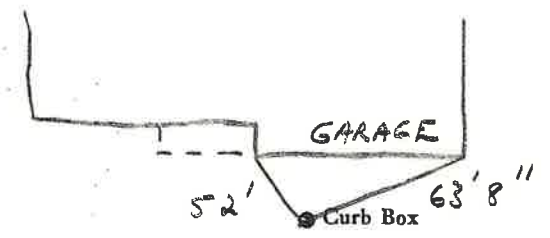

Main	Elev. of Main at tap
Gate at ●	● Gate at

● Curb Box