


LABOR AND MATERIALS

1	Copper Lead	Connection	$\frac{3}{4}$ "	\$
1	Curb	Cock Valve T.S. & V.	$\frac{3}{4}$ " in. Ori 5221	\$
1	Service box	Short $3\frac{1}{2}$ x $4\frac{1}{2}$		
	Old returned	Long $4\frac{1}{2}$ x $5\frac{1}{2}$		
		Buff or Rdway		\$
30	Ft. $\frac{3}{4}$ in.	Copper G.I. Pipe at		\$
	Nipples	in. at		\$
	Bushings	to in. at		\$
	Red'g Inc'g	Coupl'gs to in. at		\$
	Union	in. at		\$
	Meter	in. at		\$
	Lead Joints	at		\$
	Compound Joints	at		\$
	Maintenance Foreman			\$
	Hrs. Water Maint. Man-1	at		\$
	Hrs. Water Maint. Man-2	at		\$
	Hrs. Garage Foreman	at		\$
	Hrs. Labor	at		\$
	Hrs. Compressor	at		\$
	Compensation Ins.	at \$ per C		\$
	Trucking			\$
	Pav't Patch			\$
	Tap by 151690rd + 30.			\$
	6-16-65			\$
	O'head			\$

St. Haviland  
 Pl. 50  
 Ave. No. 50  
 Name of Owner Sherill Hur...

Labor and Mat'l. Report June 16 1965

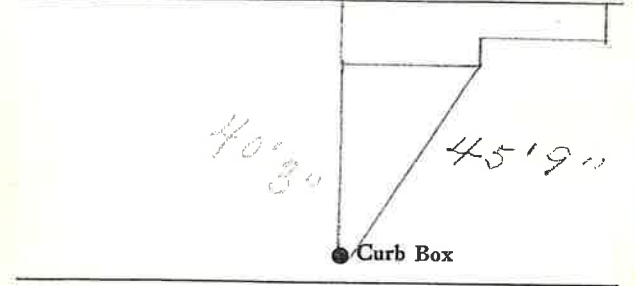

8" Main Elev. of Main at tap 5'  
 Gate at • Gate at •

• Curb Box  
 30'  $\frac{3}{4}$  To main