


Labor and Materials

1	Copper	Connection	3/4		\$ 3.20
1	Curb	Cock Valve	3/4	in.	\$ 1.70
		P.S. & V.			
1	Service Box	Short 3 1/2 x 4 1/2			\$ 1.40
	Old returned	Long 4 1/2 x 5 1/2			
		Buff. or Rdway			
24	Ft.	3/4	in.	Copper Galv. Iron Pipe at	\$ 5.28
				Cast Iron	
	Nipples			in. at	\$
	Bushings			to in. at	\$
1	Red'g	Couplings	3/4	to in. at	\$ 1.15
	Inch				
	Union			in. at	\$
	Meter			in. at	\$
	Lbs. Br. Stone	at			\$
	Lbs. Sand	at			\$
	Bags Cement	at			\$
	Paving Brick	Mack Red Asphalt		at	\$
	Lead Joints	at			\$
	Leadite Joints	at			\$
1	Hrs. Foreman	at			\$.63
2	Hrs. Common Labor	at			\$ 1.00
5	Hrs. Common Labor	at			\$ 2.03
	Hrs. Mason	at			\$
	Hrs. Mason's Helper	at			\$
	Hrs. Compressor	at			\$
	Compensation Ins.				\$
1	Trucking				\$ 1.00
	Builders' Use of Water				\$
Total					\$ 15.89

Labor and Material Report

July 13 1911

6

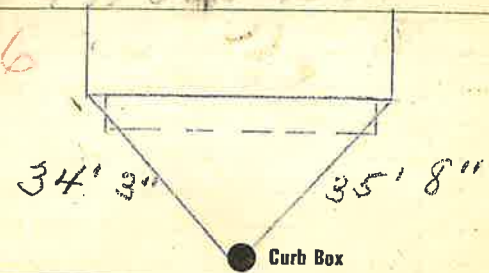

11" Main

Elev. of Main at tap 5'

Gate at ●

● Gate at

● Curb Box

drawn by
Jesse G. Norton