


Labor and Materials

Copper	} Connection.....		\$ 1.50
Lead			
Curb	} Cock Valve T.S.&W. }	in	\$ 1.70
Service Box	} Short 3 1/2 x 4 1/2 }		\$ 1.54
Old returned		Long 4 1/2 x 5 1/2 }	
		Buff. or Rdway	
6 Ft.	} Copper Galv. Iron } Pipe at		\$ 1.52
		Cast Iron	
Nipples		in. at	\$
Bushings		to in. at	\$
Red'g Inc'g	} Couplings.....to.....in.at		\$
Union		in. at	\$
Meter		in. at	\$
Lbs. Br. Stone		at	\$
Lbs. Sand		at	\$
Bags Cement		at	\$
Paving Brick	} Mack Red Asphalt } at		\$
Lead Joints		at	\$
Leadite Joints		at	\$
4 Hrs. Foreman		at 62 1/2	\$ 2.50
15 Hrs. Common Labor		at 45	\$ 6.75
Hrs. Common Labor		at	\$
Hrs. Mason		at	\$
Hrs. Masons Helper		at	\$
Hrs. Compressor		at	\$
Compensation Ins			\$ 0.33
Trucking			\$ 7.-
Builders Use of Water	Paint Patch		\$ 5.-
Total			\$ 22.84

18 *Handwritten note*

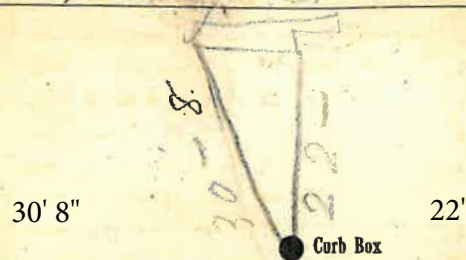

Main Elev. of Main at tap

Gate at Gate at
TAX ID # 309.12-5-3

● Curb Box

Old elect off at location
ON IN OFF POSITION

Handwritten signature

Handwritten mark