


LABOR AND MATERIALS

1	Copper	} Connection $3/4"$	\$
1	Curb		} Cock $3/4$ in.
1	Service box	} Short Long $4\frac{1}{2} \times 5\frac{1}{2}$ Dug or Reray	
7	Ft. $3/4$ in.		} Copper G. I. C. I.
	Nipples	in. at \$	
	Bushings	to in. at \$	
	Red'g	} Coupl'gs to in. at \$	
	Inc'g		
	Union	in. at \$	
	Meter	in. at \$	
	Lead Joints	at \$	
	Compound Joints	at \$	
	Maintenance Foreman	\$	
	Hrs. Water Maint. Man-1	at \$	
	Hrs. Water Maint. Man-2	at \$	
	Hrs. Garage Foreman	at \$	
	Hrs. Labor	at \$	
	Hrs. Compressor	at \$	
	Compensation Ins. at \$	per C \$	
	Trucking	\$	
	Pav't Patch	\$	
	Tap Made By St. J. H. 140	\$	
	8-30-1973	\$	
	O'head	\$	
		\$	

Henry St. Ave. No. 22
 Name of Owner
 HENAUPEX

Labor and Mat'l. Report Aug 30 1973

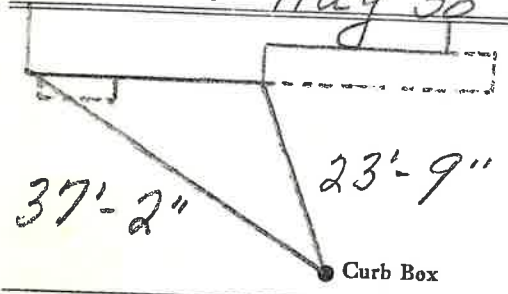

6" Main Elev. of Main at tap $2\frac{1}{2}'$
 Gate at • Gate at •

• Curb Box