

LABOR AND MATERIALS

Copper	} Connection		\$	
Lead				
Curb	} Cock } Valve } T. S. & V.	in.	\$	
Service box		} Short 3½ x 4½ } Long 4½ x 5½		
Old returned				\$
Ft. 3/4 in.	} Copper } C.I. } C.I.	Pipe at	\$	
Nipples		in. at	\$	
Bushings	to	in. at	\$	
Red'g	} Coupl'gs	to	in. at	
Inc'g				\$
Union	in. at		\$	
Meter	in. at		\$	
			\$	
Compound Joints	at		\$	
Maintenance Foreman			\$	
Hrs. Water Maint. Man-1	at		\$	
Hrs. Water Maint. Man-2	at		\$	
Hrs. Garage Foreman	at		\$	
Hrs. Labor	at		\$	
Hrs. Compressor	at		\$	
			\$	
Trucking			\$	
Pav't Patch			\$	
			\$	
			\$	
			\$	
			\$	


HENRY

St. Pt. Ave. No. 25

Name of Owner

Labor and Mat'l. Report

19 91

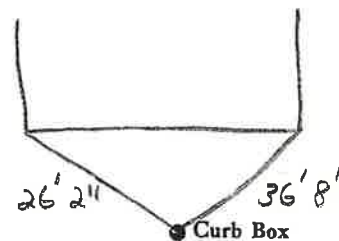

	Main	Elev. of Main at tap
Gate at ●		● Gate at
		● Curb Box