


LABOR AND MATERIALS

Copper	} Connection	_____	\$ _____	
Lead				
Curb	} Cock Valve T. S. & V. }	_____ in.	\$ _____	
Service box		} Short 3½ x 4½ Long 4½ x 5½ }		
Old returned				\$ _____
25' 6" Ft.	} Copper G.I. C.I. }	3/4 in. Pipe at	\$ _____	
Nipples	_____ in. at	\$ _____		
Bushings	_____ to _____ in. at	\$ _____		
Red'g Inc'g	} Coupl'gs	_____ to _____ in. at	\$ _____	
Union		_____ in. at	\$ _____	
Meter	_____ in. at	\$ _____		
Compound Joints	at	\$ _____		
Maintenance Foreman		\$ _____		
Hrs. Water Maint. Man—1	at	\$ _____		
Hrs. Water Maint. Man—2	at	\$ _____		
Hrs. Garage Foreman	at	\$ _____		
Hrs. Labor	at	\$ _____		
Hrs. Compressor	at	\$ _____		
Trucking		\$ _____		
Pav't Patch		\$ _____		
		\$ _____		
		\$ _____		
		\$ _____		
		\$ _____		

St. 27
 Pl. Henry
 Ave. No. ~~275~~ 29
 Name of Owner _____

Labor and Mat'l. Report _____ 19 91

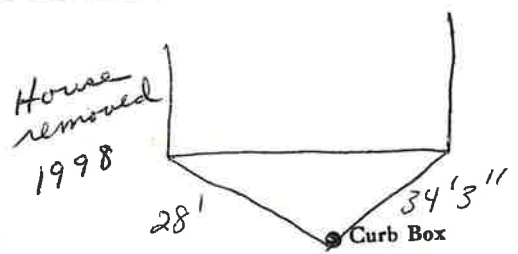

Main _____ Elev. of Main at tap _____
 Gate at • _____ Gate at _____
 • Curb Box