

LABOR AND MATERIALS

1	Copper Lead	Connection	3/4	\$	1.59
1	Curb	Cock Valve T. S. & V.	3/4 in.	\$	2.74
1	Service Box Old returned	Short 3/4x4 1/2 Long 4 1/2x5 1/2 Buffer Rdway		\$	1.82
31	Ft.	3/4 in.	Copper Galv Iron Cast Iron	Pipe at	5.70
	Nipples	in. at		\$	
	Bushings	to in. at		\$	
	Red'g Inc'g	Couplings	to in. at	\$	
	Union	in. at		\$	
	Meter	in. at		\$	
	Lead Joints at			\$	
	Leadite Joints at			\$	
	Hrs. Foreman at			\$	
19	Hrs. Chauffeur at	6 3/4		\$	13.06
4	Hrs. Tapper at	7		\$	2.75
7	Hrs. Labor at	6 1/2		\$	4.38
16	Hrs. Labor at	60		\$	9.60
9	Hrs. Compressor at	9 1/2		\$	7.82
	Compensation Ins.			\$	66
	Trucking			\$	1.00
	Builders Use of Water	Patch ?		\$	5.00
	Taylor, Matusinski			\$	
				\$	
				\$	
				\$	
	Patch ?			\$	51.18

St.
Pl.
Ave. No. 31


Name of Owner

Dorey

Labor and Mat'l. Report

Mar 6

19 11

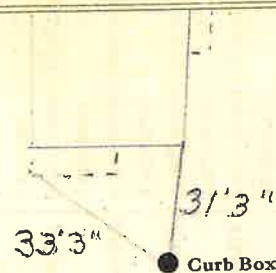

6 Main Elev. of Main at tap

Gate at ● Gate at ●

● Curb Box