

LABOR AND MATERIALS

Copper	} Connection	_____	\$	
Lead		_____		
Curb	} Cock } Valve } T. S. & V.	_____ in.	\$	
Service box		} Short 3½ x 4½ } Long 4½ x 5½	_____	
Old returned			_____	\$
27 Ft. ¾ in.	} Copper } C.I. } C.I.	_____ Pipe at	\$	
Nipples		_____ in. at	\$	
Bushings	_____ to _____ in.	at	\$	
Red'g	} Coupl'gs	_____ to _____ in.	at	
Inc'g		_____	\$	
Union	_____ in.	at	\$	
Meter	_____ in.	at	\$	
			\$	
Compound Joints	_____ at		\$	
Maintenance Foreman	_____ at		\$	
Hrs. Water Maint. Man-1	_____ at		\$	
Hrs. Water Maint. Man-2	_____ at		\$	
Hrs. Garage Foreman	_____ at		\$	
Hrs. Labor	_____ at		\$	
Hrs. Compressor	_____ at		\$	
			\$	
Trucking	_____ at		\$	
Pav't Patch	_____ at		\$	
			\$	
			\$	
			\$	
			\$	

HENRY


St. ~~Pl.~~ Ave. No. 33

Name of Owner

TAX ID # 309.12-12-10


Labor and Mat'l. Report

19 89

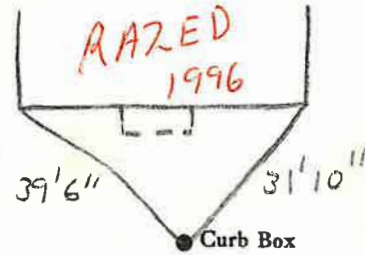

	Main	Elev. of Main at tap
Gate at	•	• Gate at

UPDATED 11/6/03 • Curb Box

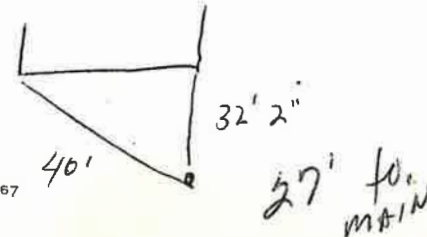

LSM-5C-6-1-67