

LABOR AND MATERIALS

1	Copper Lead	Connection	3/4"		\$ 2.41
1	Curb	Cock Valve T. S. & V.	3/4" in.		\$ 3.41
1	Service box	Short 3/4 X 4 1/2 Long 4 1/2 X 5 1/2 Buff or Rdway			\$ 4.18
29	Ft.	Copper C.I.	3/4" in.	Pipe at 40	\$ 11.60
	Nipples		in. at		\$
	Bushings		to in. at		\$
	Inc'g	Red'g Coupl'gs	to in. at		\$
	Union		in. at		\$
	Meter		in. at		\$
	Lead Joints		at		\$
	Compound Joints		at		\$
	Hrs. Water Maint. Man-1		at		\$
7	Hrs. Water Maint. Man-2		at 1.24		\$ 8.68
16	Hrs. Labor		at 1.13		\$ 18.08
	Hrs. Labor		at		\$
	Hrs. Compressor		at		\$
	Compensation Ins.		at \$ 2.86/per C.		\$ 1.03
	Trucking				\$ 1.50
	Pay't Patch				\$ 15.30
	Tap by Gifford 12-15-53				\$
	O'head				\$
					\$ 66.19

50.89


4-54

Henry

St. ~~Pl.~~ Ave. No. 35

Name of Owner King

Labor and Mat'l. Report Dec. 15 1953

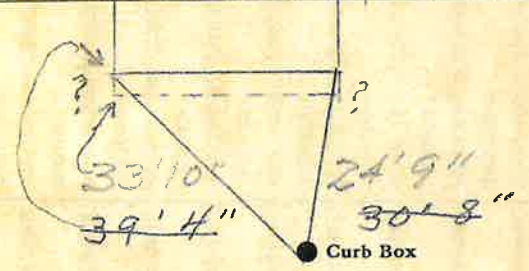

6" Main Elev. of Main at tap 5'

Gate at ● ● Gate at

● Curb Box