


LABOR AND MATERIALS

1	Copper	Connection	3/4	\$	3.08
1	Lead	Cock	3/4 in.	\$	3.89
1	Curb	Valve	3/4 in.	\$	
		T. S. & V.		\$	
Same	Service box	Short 3 1/2 x 4 1/2		\$	
	Old returned	Long 4 1/2 x 5 1/2		\$	
		Buff or Rdway		\$	
13	Ft.	Copper	3/4 in.	\$	5.85
		G. I.		\$	
		G. I.		\$	
		Pipe at	45	\$	
	Nipples	in. at		\$	
	Bushings	to in. at		\$	
	Red'g	Coupl'gs to in. at		\$	
	Inc'g			\$	
	Union	in. at		\$	
	Meter	in. at		\$	
	Lead Joints at			\$	
	Compound Joints at			\$	
	Maintenance Foreman			\$	
6	Hrs. Water Maint. Man-1	at		\$	9.68
6	Hrs. Water Maint. Man-2	at 1.613		\$	
6	Hrs. Garage Foreman	at		\$	7.80
6	Hrs. Labor	at 1.30		\$	
	Hrs. Compressor at			\$	
	Compensation Ins. at	\$5.696 per C		\$.99
	Trucking			\$	1.50
	Pav't Patch			\$	9.00
	Tap by Gifford +			\$	
	Peterson 4-10-56			\$	
	O'head			\$	
				\$	41.79

St. Henry
 Pt. 38
 Ave. No. 38

Name of Owner Whittemore

Labor and Mat'l. Report April 10 1956

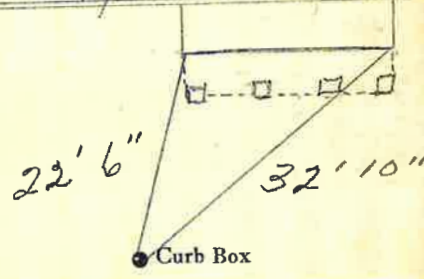

6" Main Elev. of Main at tap 5'
 Gate at • Gate at •

TAX ID # 309.12-12-27.1

• Curb Box