

## LABOR AND MATERIALS

Copper	} Connection				
Lead				\$	
Curb	Cock	}	in.		\$
	Valve				
	T.S. & V.				
Service box	{ Short 3-1/2 x 4-1/2				\$
Old returned	{ Long 4-1/2 x 5-1/2				\$
8	3/4	Copper	Pipe at		\$
	Ft.	3/4	in.		
		Curb			\$
		G.I.			\$
Nipples			in. at		\$
Bushings			to in. at		\$
Red'g					\$
Inc'g					\$
Union			in. at		\$
Meter			in. at		\$
					\$
Compound Joints			at		\$
Maintenance Foreman					\$
Hrs. Water Maint. Man - 1			at		\$
Hrs. Water Maint. Man - 2			at		\$
Hrs. Garage Foreman			at		\$
Hrs. Labor			at		\$
Hrs. Compressor			at		\$
					\$
Trucking					\$
Pav't Patch					\$
					\$
					\$
HENRY

St  
Pt.  
Ave. No.


42

Name of Owner

COONS

Labor and Mat'l. Report 19

11-9-2001

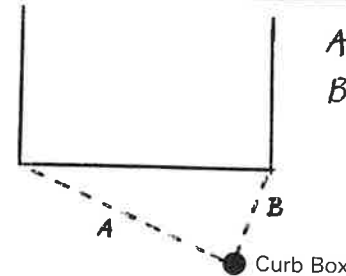

6"

Main

Elev. of  
Main at tap

Gate at ●

● Gate at

● Curb Box

SEWER MAIN IS  
13' FROM CURB BOX.