

LABOR AND MATERIALS

1	Copper Lead	Connection	3/4"	\$	_____
1	Curb	Cock Valve T. S. & V.	3/4" in.	\$	_____
1	Service box Old returned	Short 3 1/2 x 4 1/2 Long 4 1/2 x 5 1/2 Buff or Rdway		\$	_____
29	Ft.	3/4" in.	Copper G.I. Pipe at	\$	_____
	Nipples	in. at		\$	_____
	Bushings	to in. at		\$	_____
	Red'g Inc'g	Coupl'gs to in. at		\$	_____
	Union	in. at		\$	_____
	Meter	in. at		\$	_____
	Lead Joints	at		\$	_____
	Compound Joints	at		\$	_____
	Maintenance Foreman			\$	_____
	Hrs. Water Maint. Man	—1 at		\$	_____
	Hrs. Water Maint. Man	—2 at		\$	_____
	Hrs. Garage Foreman	at		\$	_____
	Hrs. Labor	at		\$	_____
	Hrs. Compressor	at		\$	_____
	Compensation Ins.	at \$ _____ per C		\$	_____
	Trucking			\$	_____
	Pav't Patch			\$	_____
	Tap by Giggard & Co.	8-16-60.		\$	_____
	O'head			\$	_____
				\$	_____

V

St. \_\_\_\_\_  
Pl. \_\_\_\_\_  
Ave. No. 43

Name of Owner Henry  
Ross M. Cook

Labor and Mat'l. Report Aug. 16 1960.

6" Main

Elev. of Main at tap 5 1/2'

Gate at ●

● Gate at

● Curb Box

● Curb Box

27' 4" 25'

LSM-5C-2-5 56


27' 4" 25'

# LABOR AND MATERIALS

_____	Copper } Connection _____	\$ _____
_____	Lead } _____	\$ _____
_____	Curb } Cock } _____ in. _____	\$ _____
	} Valve } _____	
	} T.S. & V. }	
_____	Service box { Short 3-1/2 x 4-1/2 } _____	\$ _____
_____	Old returned { Long 4-1/2 x 5-1/2 } _____	\$ _____
_____	Ft. _____ in. { Copper } Pipe at _____	\$ _____
	} G.I. }	
	} C.I. }	
_____	Nipples _____ in. at _____	\$ _____
_____	Bushings _____ to _____ in. at _____	\$ _____
_____	Red'g _____	\$ _____
_____	Inc'g _____	\$ _____
_____	Union _____ in. at _____	\$ _____
_____	Meter _____ in. at _____	\$ _____
_____	_____	\$ _____
_____	Compound Joints at _____	\$ _____
_____	Maintenance Foreman _____	\$ _____
_____	Hrs. Water Maint. Man - 1 at _____	\$ _____
_____	Hrs. Water Maint. Man - 2 at _____	\$ _____
_____	Hrs. Garage Foreman _____ at _____	\$ _____
_____	Hrs. Labor _____ at _____	\$ _____
_____	Hrs. Compressor at _____	\$ _____
_____	_____	\$ _____
_____	Trucking _____	\$ _____
_____	Pav't Patch _____	\$ _____
_____	_____	\$ _____
_____	_____	\$ _____
Henry st. St. Ave. No. 43  
 Name of Owner  
 Outside Cleanout

Labor and Mat'l. Report 19

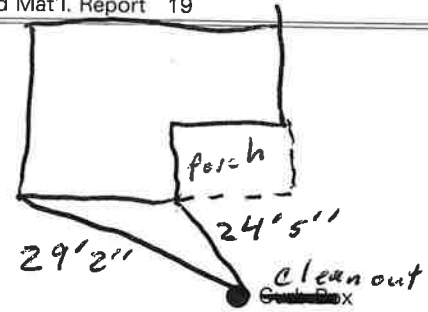

\_\_\_\_\_ Main Elev. of Main at tap \_\_\_\_\_  
 Gate at ● Gate at ●  
 ● Curb Box