


LABOR AND MATERIALS

1	Copper	} Connection	3/4"	\$	_____
	Lead				
1	Curb	} Valve	3/4 in.	\$	_____
Same	Service box	} Short 3 1/2 x 4 1/2	}	\$	_____
	Old returned				
		Buff. or Rdway			
13	Ft.	} Pipe at	3/4 in.	\$	_____
		G.I.			
		C.I.			
	Nipples	in. at		\$	_____
	Bushings	to in. at		\$	_____
	Red'g	} Coupl'gs	to in. at	\$	_____
	Inc'g				
	Union	in. at		\$	_____
	Meter	in. at		\$	_____
	Lead Joints	at		\$	_____
	Compound Joints	at		\$	_____
	Maintenance Foreman			\$	_____
	Hrs. Water Maint. Man	1 at		\$	_____
	Hrs. Water Maint. Man	2 at		\$	_____
	Hrs. Garage Foreman	at		\$	_____
	Hrs. Labor	at		\$	_____
	Hrs. Compressor	at		\$	_____
	Compensation Ins.	at \$ _____ per C		\$	_____
	Trucking			\$	_____
	Pav't Patch			\$	_____
	Tap by Miller & Co.			\$	_____
	6-7-57			\$	_____
	O'head			\$	_____
				\$	_____

Henry St. Pt. Ave. No. 48

Name of Owner Lazure

Labor and Mat'l. Report June 7 1957

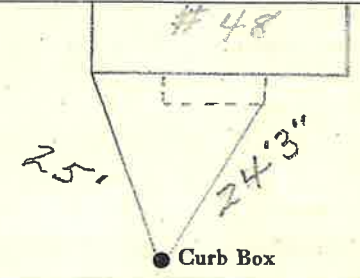

6" Main Elev. of Main at tap 5'

Gate at • Gate at

• Curb Box