

Labor and Materials

1. Copper } Connection ^{3/4"}	\$ 96
Lead }	
1. Curb { Cock Valve } ^{3/4"} in	\$ 1.33
{ T.S.&V. }	
1. Service Box { Short 3 1/2 x 4 1/2 }	\$ 1.35
{ Long 4 1/2 x 5 1/2 }	
Old returned { Buff. or Rd.wor. }	
27 Ft. 3/4" in. { Copper } Pipe at 15.....	\$ 4.05
{ Galv. Iron }	
{ Cast Iron }	
Nipples in. at	\$
Bushings to in. at	\$
Red'g } Couplings to in. at	\$
Inc'g }	
Union in. at	\$
Meter in. at	\$
Lbs. Br. Stone at	\$
Lbs. Sand at	\$
Bags Cement at	\$
Paving Brick { Mack } at	\$
{ Red }	
{ Asphalt }	
Lead Joints at	\$
Leadite Joints at	\$
7 Hrs. Foreman ^{chauff} at 62 1/2.....	\$ 1.25
8 Hrs. Common Labor at 45.....	\$ 3.60
Hrs. Common Labor at	\$
Hrs. Mason at	\$
Hrs. Masons Helper at	\$
Hrs. Compressor at	\$
Compensation Ins at	\$ 1.15
Trucking at	\$ 1.00
Builders Use of Water ^{no patch}	\$


Total \$13.69

76-36

Labor and Material Report Aug 25 19

49 Henry St. Tap
Hall

TO BE
RAZED

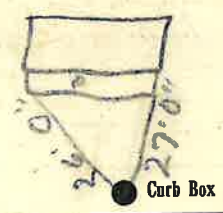

6" Main

Elev. of Main at tap 5

Gate at ●

● Gate at

● Curb Box

Old tap shut off

SHUT OFF AT CURB
(1996)

[Handwritten signature]