

LABOR AND MATERIALS


1	Copper	} Connection	3/4"	\$ 2.71
1	Lead			
1	Curb	} Cock Valve T.S. & V.	} 3/4 in.	\$ 3.83
1	Service box			
Old returned				
		} Short 3 1/2 x 4 1/2 Long 4 1/2 x 5 1/2 Buff or Rdway		\$ 4.69
24	Ft. 3/4 in.			
		} Copper O.I. C.I.	} Pipe at 45	\$ 10.80
	Nipples	in. at		\$
	Bushings	to in. at		\$
	Red'g Inc'g	} Coupl'gs	to in. at	\$
	Union			
	Meter	in. at		\$
	Lead Joints at			\$
	Compound Joints at			\$
	Maintenance Foreman			\$ 2.36
	Hrs. Water Maint. Man-1 at			\$ 2
	Hrs. Water Maint. Man-2 at			\$
6	Hrs. Garage Foreman	at 1.59		\$ 9.54
14	Hrs. Labor	at 1.13		\$ 15.82
	Hrs. Compressor at			\$
	Compensation Ins. at \$ 4.29 per C			\$ 1.09
	Trucking			\$ 1.50
	Pay't Patch			\$ 12.60
	Tap by Larcou & Wadleigh			\$
	11-30-55			\$
	O'head			\$
				\$ 62.58

Patch 2
19.98

Henry St. PL Ave. No. 51
Name of Owner

Creedon

Labor and Mat'l. Report Nov. 30 1955

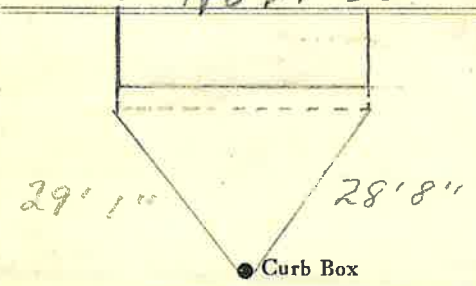

6" Main Elev. of Main at tap 5'
Gate at • Gate at •

• Curb Box