


# LABOR AND MATERIALS

\_\_\_\_\_ Copper } Connection \_\_\_\_\_ \$ \_\_\_\_\_  
 \_\_\_\_\_ Lead }  
 \_\_\_\_\_ Curb } Cock } \_\_\_\_\_ in. \_\_\_\_\_ \$ \_\_\_\_\_  
 \_\_\_\_\_ Valve }  
 \_\_\_\_\_ T.S. & V. }  
 \_\_\_\_\_ Service box { Short 3-1/2 x 4-1/2 } \_\_\_\_\_ \$ \_\_\_\_\_  
 \_\_\_\_\_ Old returned { Long 4-1/2 x 5-1/2 }  
1.5 Ft. 1 in. { Copper } Pipe at \_\_\_\_\_ \$ \_\_\_\_\_  
 \_\_\_\_\_ Nipples \_\_\_\_\_ in. at \_\_\_\_\_ \$ \_\_\_\_\_  
 \_\_\_\_\_ Bushings \_\_\_\_\_ to \_\_\_\_\_ in. at \_\_\_\_\_ \$ \_\_\_\_\_  
 \_\_\_\_\_ Red'g \_\_\_\_\_  
 \_\_\_\_\_ Inc'g \_\_\_\_\_  
 \_\_\_\_\_ Union \_\_\_\_\_ in. at \_\_\_\_\_ \$ \_\_\_\_\_  
 \_\_\_\_\_ Meter \_\_\_\_\_ in. at \_\_\_\_\_ \$ \_\_\_\_\_  
 \_\_\_\_\_ \$ \_\_\_\_\_  
 \_\_\_\_\_ Compound Joints at \_\_\_\_\_ \$ \_\_\_\_\_  
 \_\_\_\_\_ Maintenance Foreman \_\_\_\_\_ \$ \_\_\_\_\_  
 \_\_\_\_\_ Hrs. Water Maint. Man - 1 at \_\_\_\_\_ \$ \_\_\_\_\_  
 \_\_\_\_\_ Hrs. Water Maint. Man - 2 at \_\_\_\_\_ \$ \_\_\_\_\_  
 \_\_\_\_\_ Hrs. Garage Foreman \_\_\_\_\_ at \_\_\_\_\_ \$ \_\_\_\_\_  
 \_\_\_\_\_ Hrs. Labor \_\_\_\_\_ at \_\_\_\_\_ \$ \_\_\_\_\_  
 \_\_\_\_\_ Hrs. Compressor at \_\_\_\_\_ \$ \_\_\_\_\_  
 \_\_\_\_\_ \$ \_\_\_\_\_  
 \_\_\_\_\_ Trucking \_\_\_\_\_ \$ \_\_\_\_\_  
 \_\_\_\_\_ Pav't Patch \_\_\_\_\_ \$ \_\_\_\_\_  
 \_\_\_\_\_ \$ \_\_\_\_\_  
 \_\_\_\_\_ \$ \_\_\_\_\_  
St. \_\_\_\_\_  
 Ave. No. 2  
Henry

Name of Owner  
Matt Ball

Labor and Mat'l. Report 12/7/11  
Tap is on Basin St.

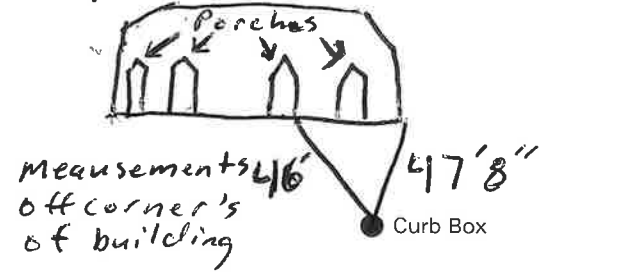

6" Main Elev. of Main at tap 8'

