

Labor and Materials

1	Copper Lead	Connection	3/4	\$ 2.87
1	Curb	Cock Walters T. S. & V.	3/4 in	\$ 3.62
	Service Box Old returned	Short 3 1/2 x 4 1/2 Long 4 1/2 x 5 1/2 Buff. or Rdway		} Same \$ —
6	Ft.	3/4 in.		
4		Copper Galv. Iron Cast Iron	Pipe at	37 \$ 1.92
	Nipples	in. at		\$
	Bushings	to	in. at	\$
	Red'g Inc'g	Couplings	to	in. at \$
	Union	in. at		\$
	Meter	in. at		\$
	Lead Joints at			\$
	Leadite Joints at			\$
6	Hrs. Foreman at	W.M.M. 1 @ 1.12		\$ 6.72
2	Hrs. Chauffeur at	W.M.M. 2 @ 1.02		\$ 2.04
	Hrs. Tapper at			\$
19	Hrs. Labor at	91		\$ 17.29
	Hrs. Labor at			\$
2	Hrs. Compressor at	(Sewer Dept) 1.70		\$ 2
	Compensation Ins.	@ 2.18		\$.57
	Trucking			\$ 2.00
	Builders Use of Water	Patch		\$ 10.25
	Tap by Miller			\$
	Compressor Sewer Dept			\$
	241			\$
				\$
				\$ 47.28

10


Henry

St. Pt. Ave. No. 10

Name of Owner

Naillon

Labor and Mat'l. Report Mar 5 1949

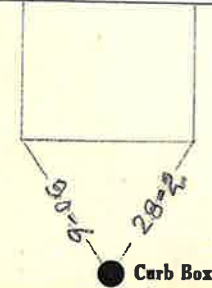

6 Main

Elev. of Main at tap 6'

Gate at ●

● Gate at

● Curb Box